
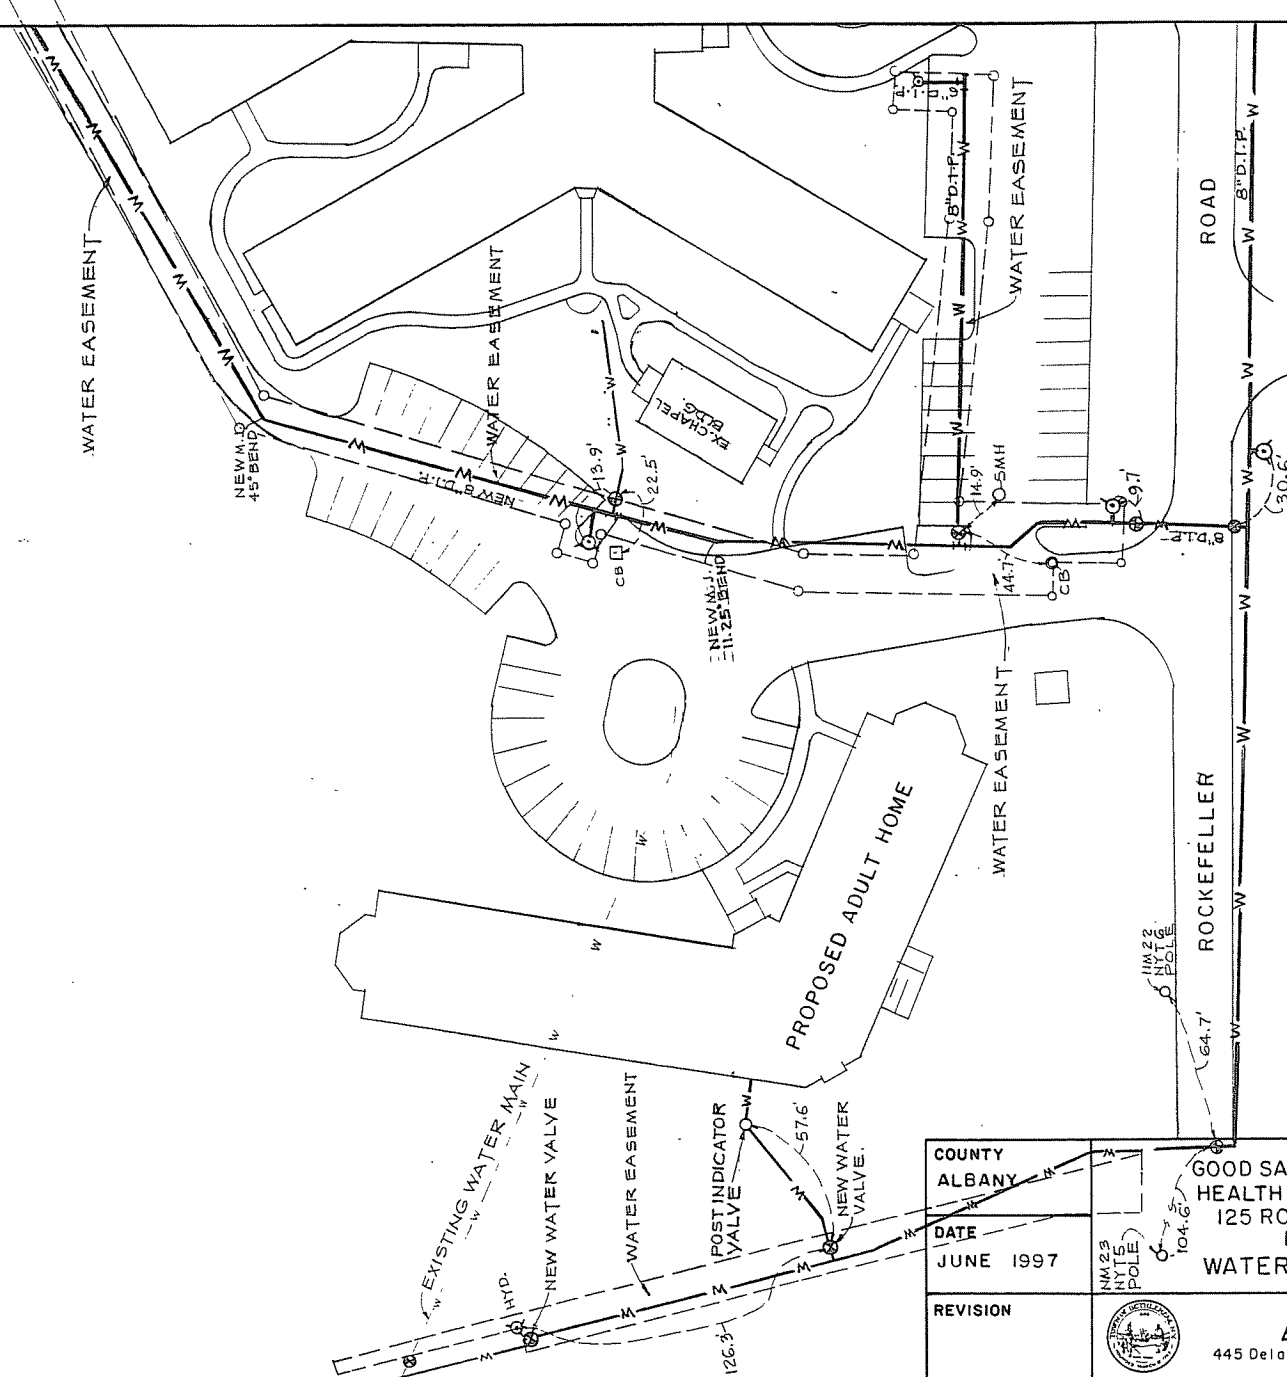


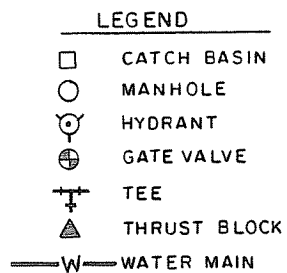

COUNTY ALBANY		STATE NEW YORK
DATE JUNE 1997		SCALE 1" = 50'
REVISION	 <i>TOWN OF BETHLEHEM ENGINEERING DIVISION</i> 445 Delaware Ave. Delmar, New York 12054	DRAWING NO. 2 OF 2
(Empty revision box)		(Empty drawing number box)