
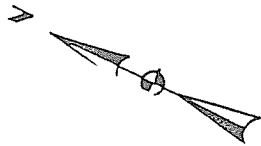


LEGEND

-  CATCH BASIN
-  MANHOLE
-  HYDRANT
-  GATE VALVE
-  TEE
-  THRUST BLOCK
-  WATER MAIN

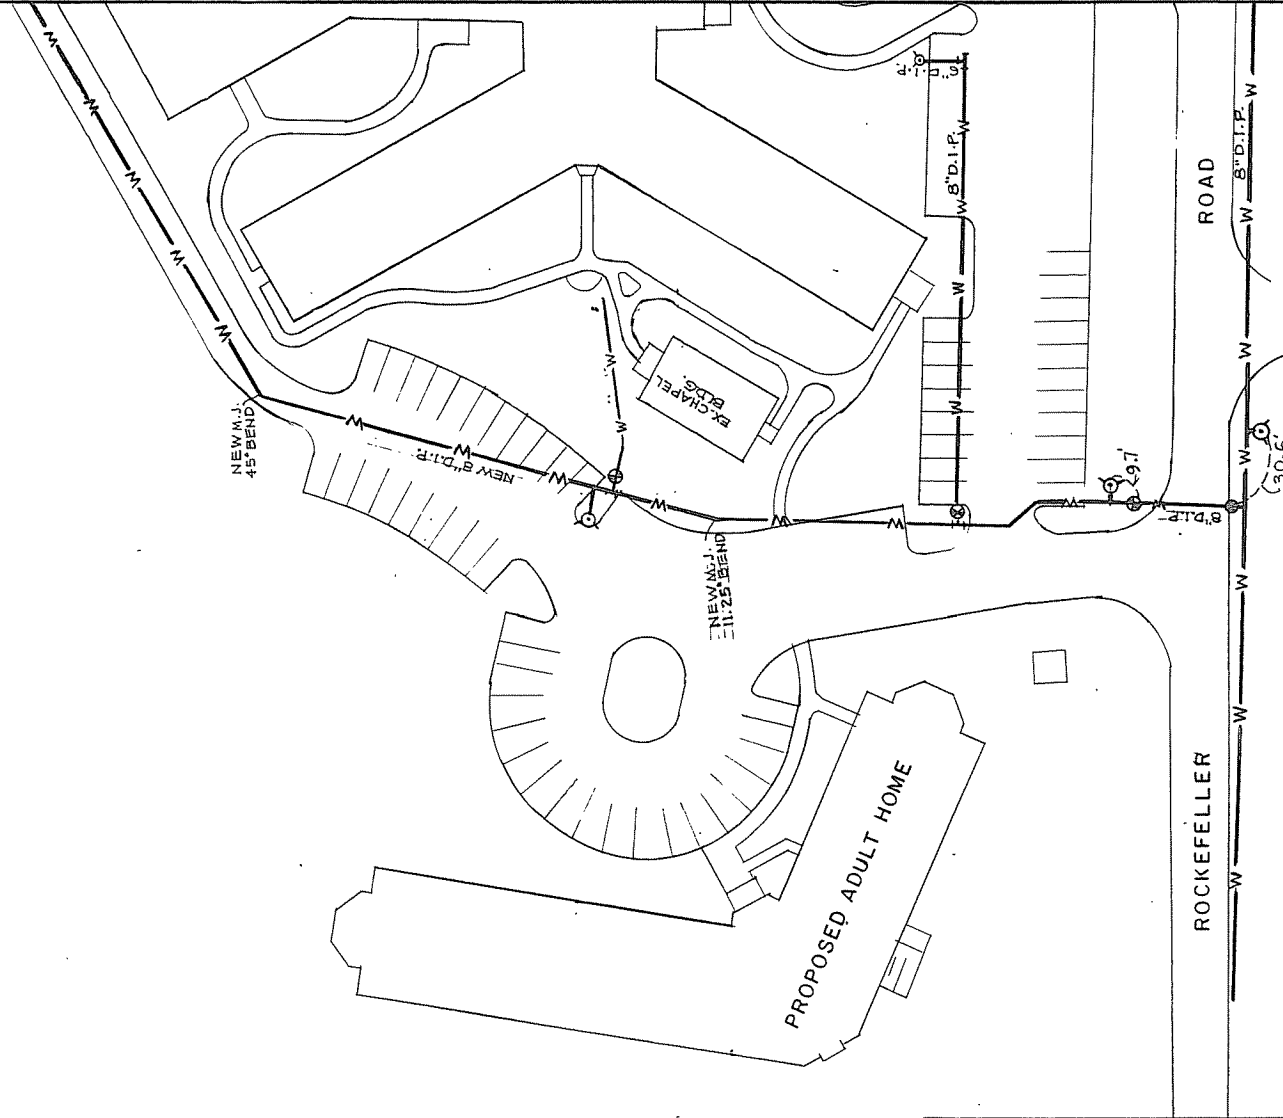

COUNTY ALBANY	GOOD SAMARITAN LUTHERAN HEALTH CARE CENTER INC. 125 ROCKEFELLER ROAD DELMAR, N. Y. WATER MAIN LOCATION	STATE NEW YORK
DATE JUNE 1997		SCALE 1" = 50'
REVISION	 TOWN OF BETHLEHEM ENGINEERING DIVISION 445 Delaware Ave. Delmar, New York 12054	DRAWING NO. 2 OF 2