



- LEGEND
- CATCH BASIN
 - MANHOLE
 - ⊙ HYDRANT
 - ⊕ GATE VALVE
 - + TEE
 - ▽ THRUST BLOCK
 - W — WATER MAIN

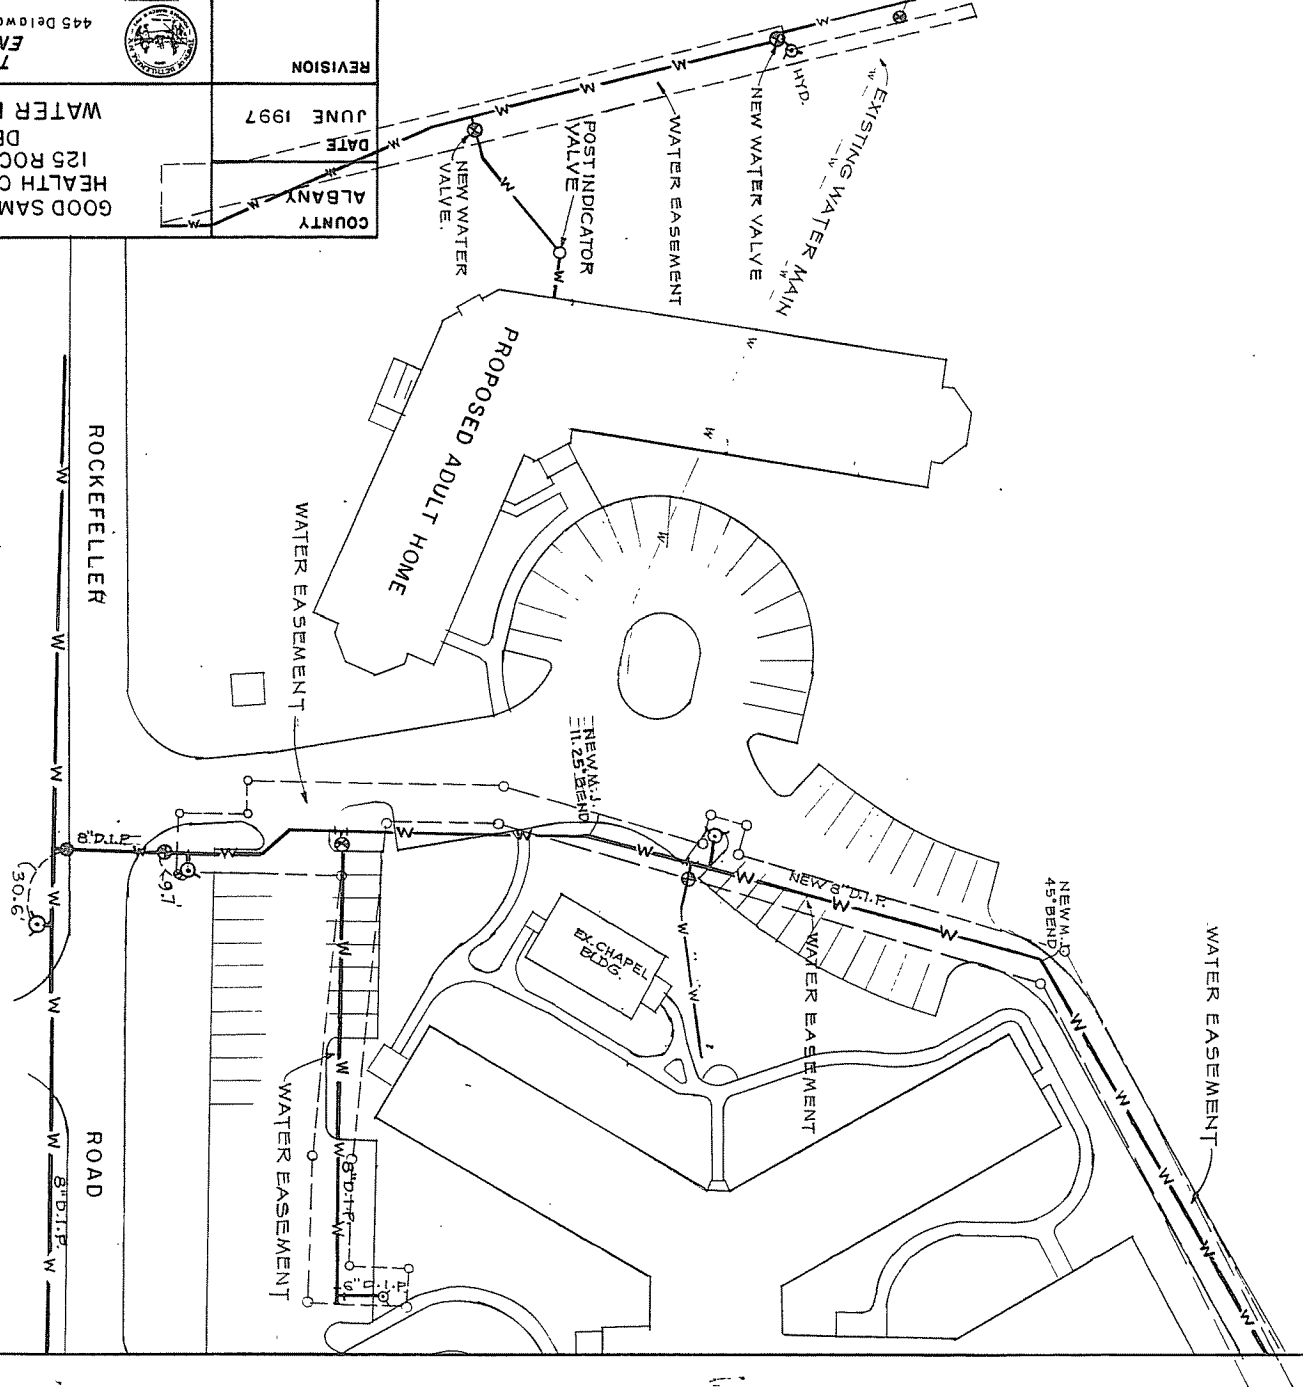

REVISION	DATE	COUNTY
	JUNE 1997	ALBANY

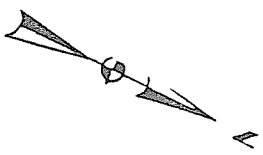

GOOD SAMARITAN LUTHERAN
HEALTH CARE CENTER INC.
125 ROCKEFELLER ROAD
DELMAR, N. Y.
WATER MAIN LOCATION

TOWN OF BETHLEHEM
ENGINEERING DIVISION

445 Delaware Ave. Delmar, New York 12054

STATE NEW YORK
SCALE 1" = 50'
DRAWING NO. 2 OF 2