


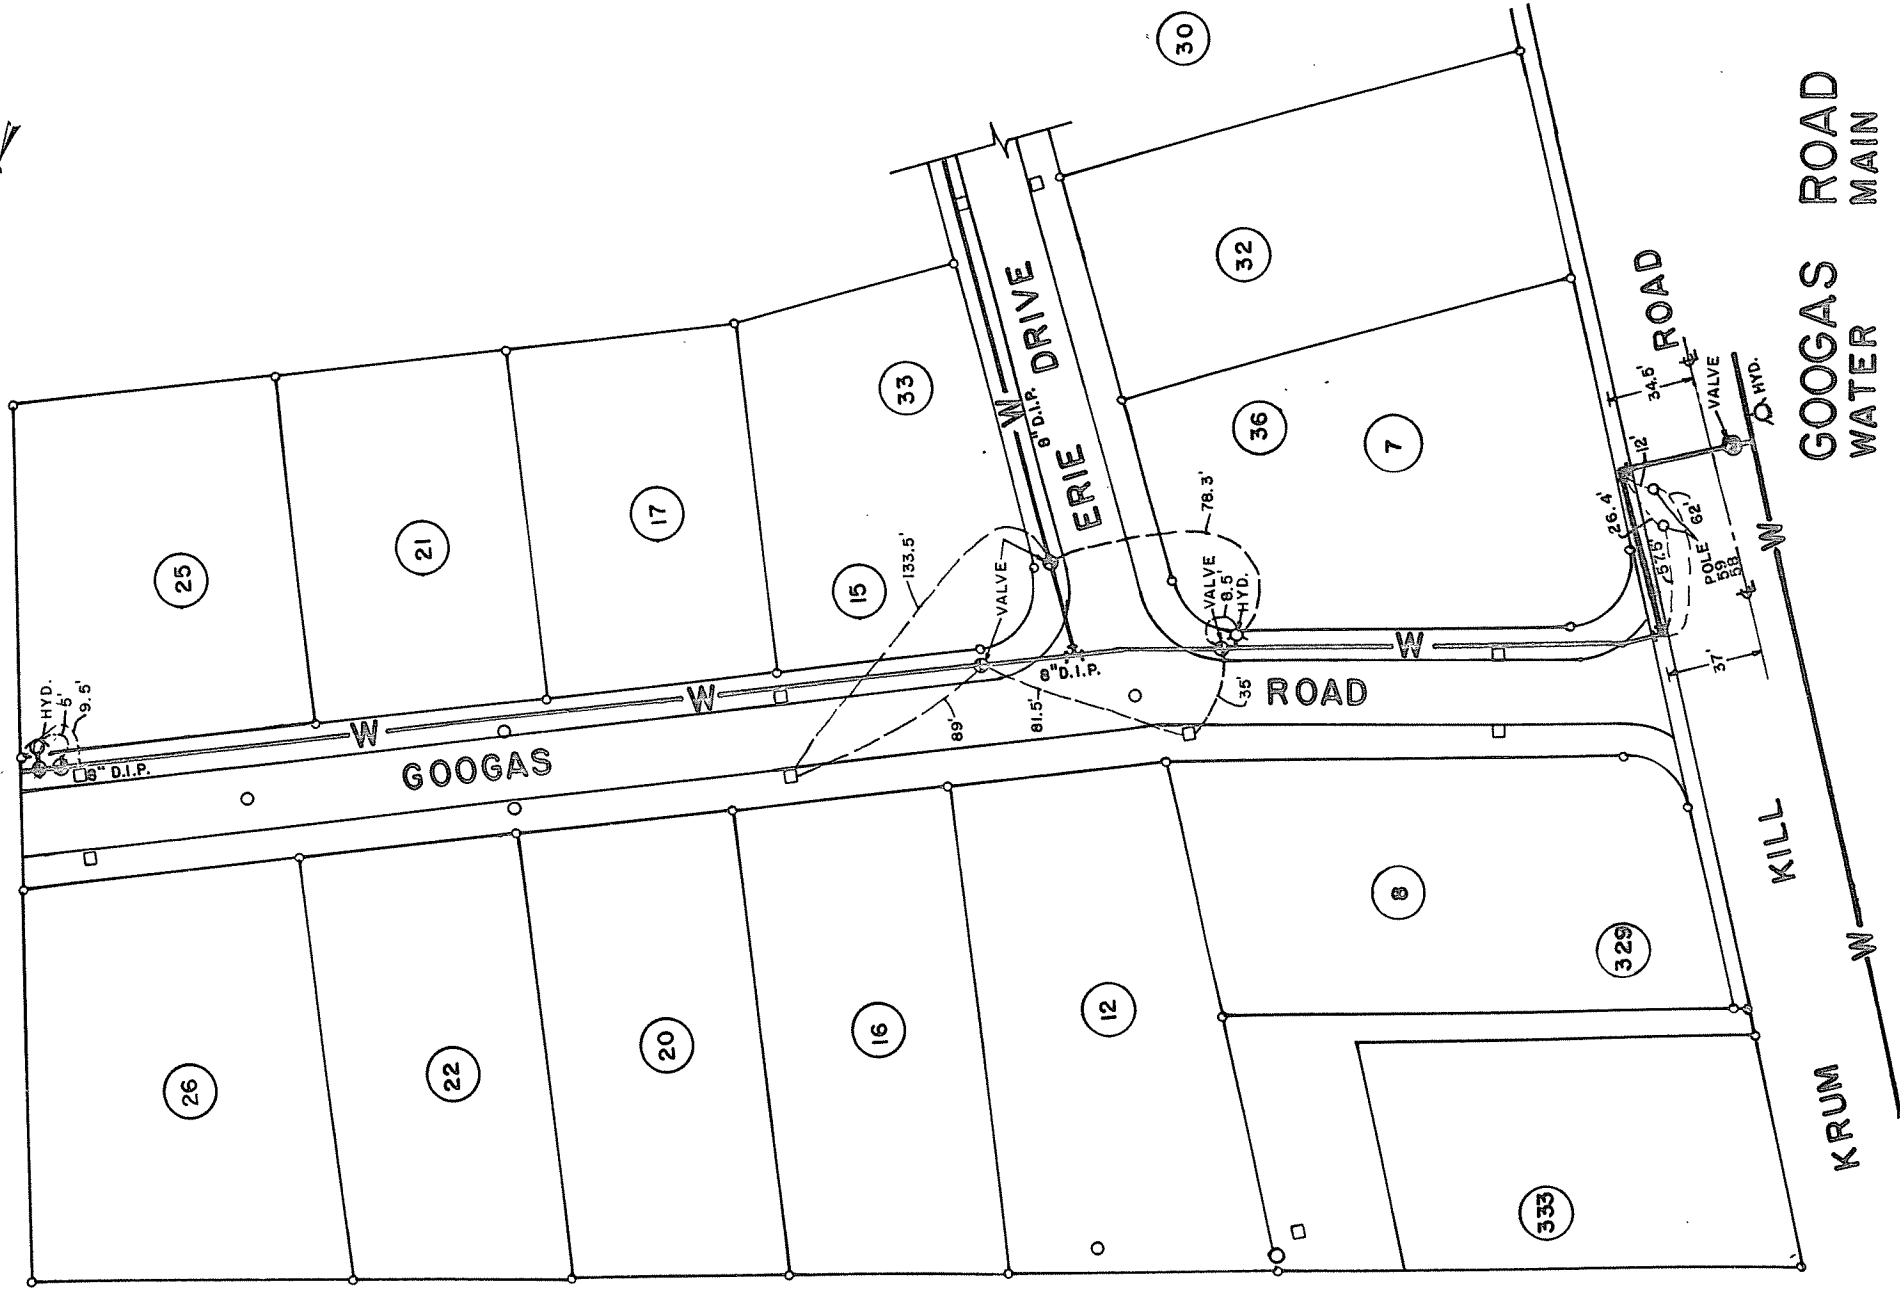

GOOGAS ROAD
WATER MAIN

OCT. 8, 1991
SCALE: 1" = 50'

DRAWN BY M.G.
CHECKED BY

RECORD
DRAWING