


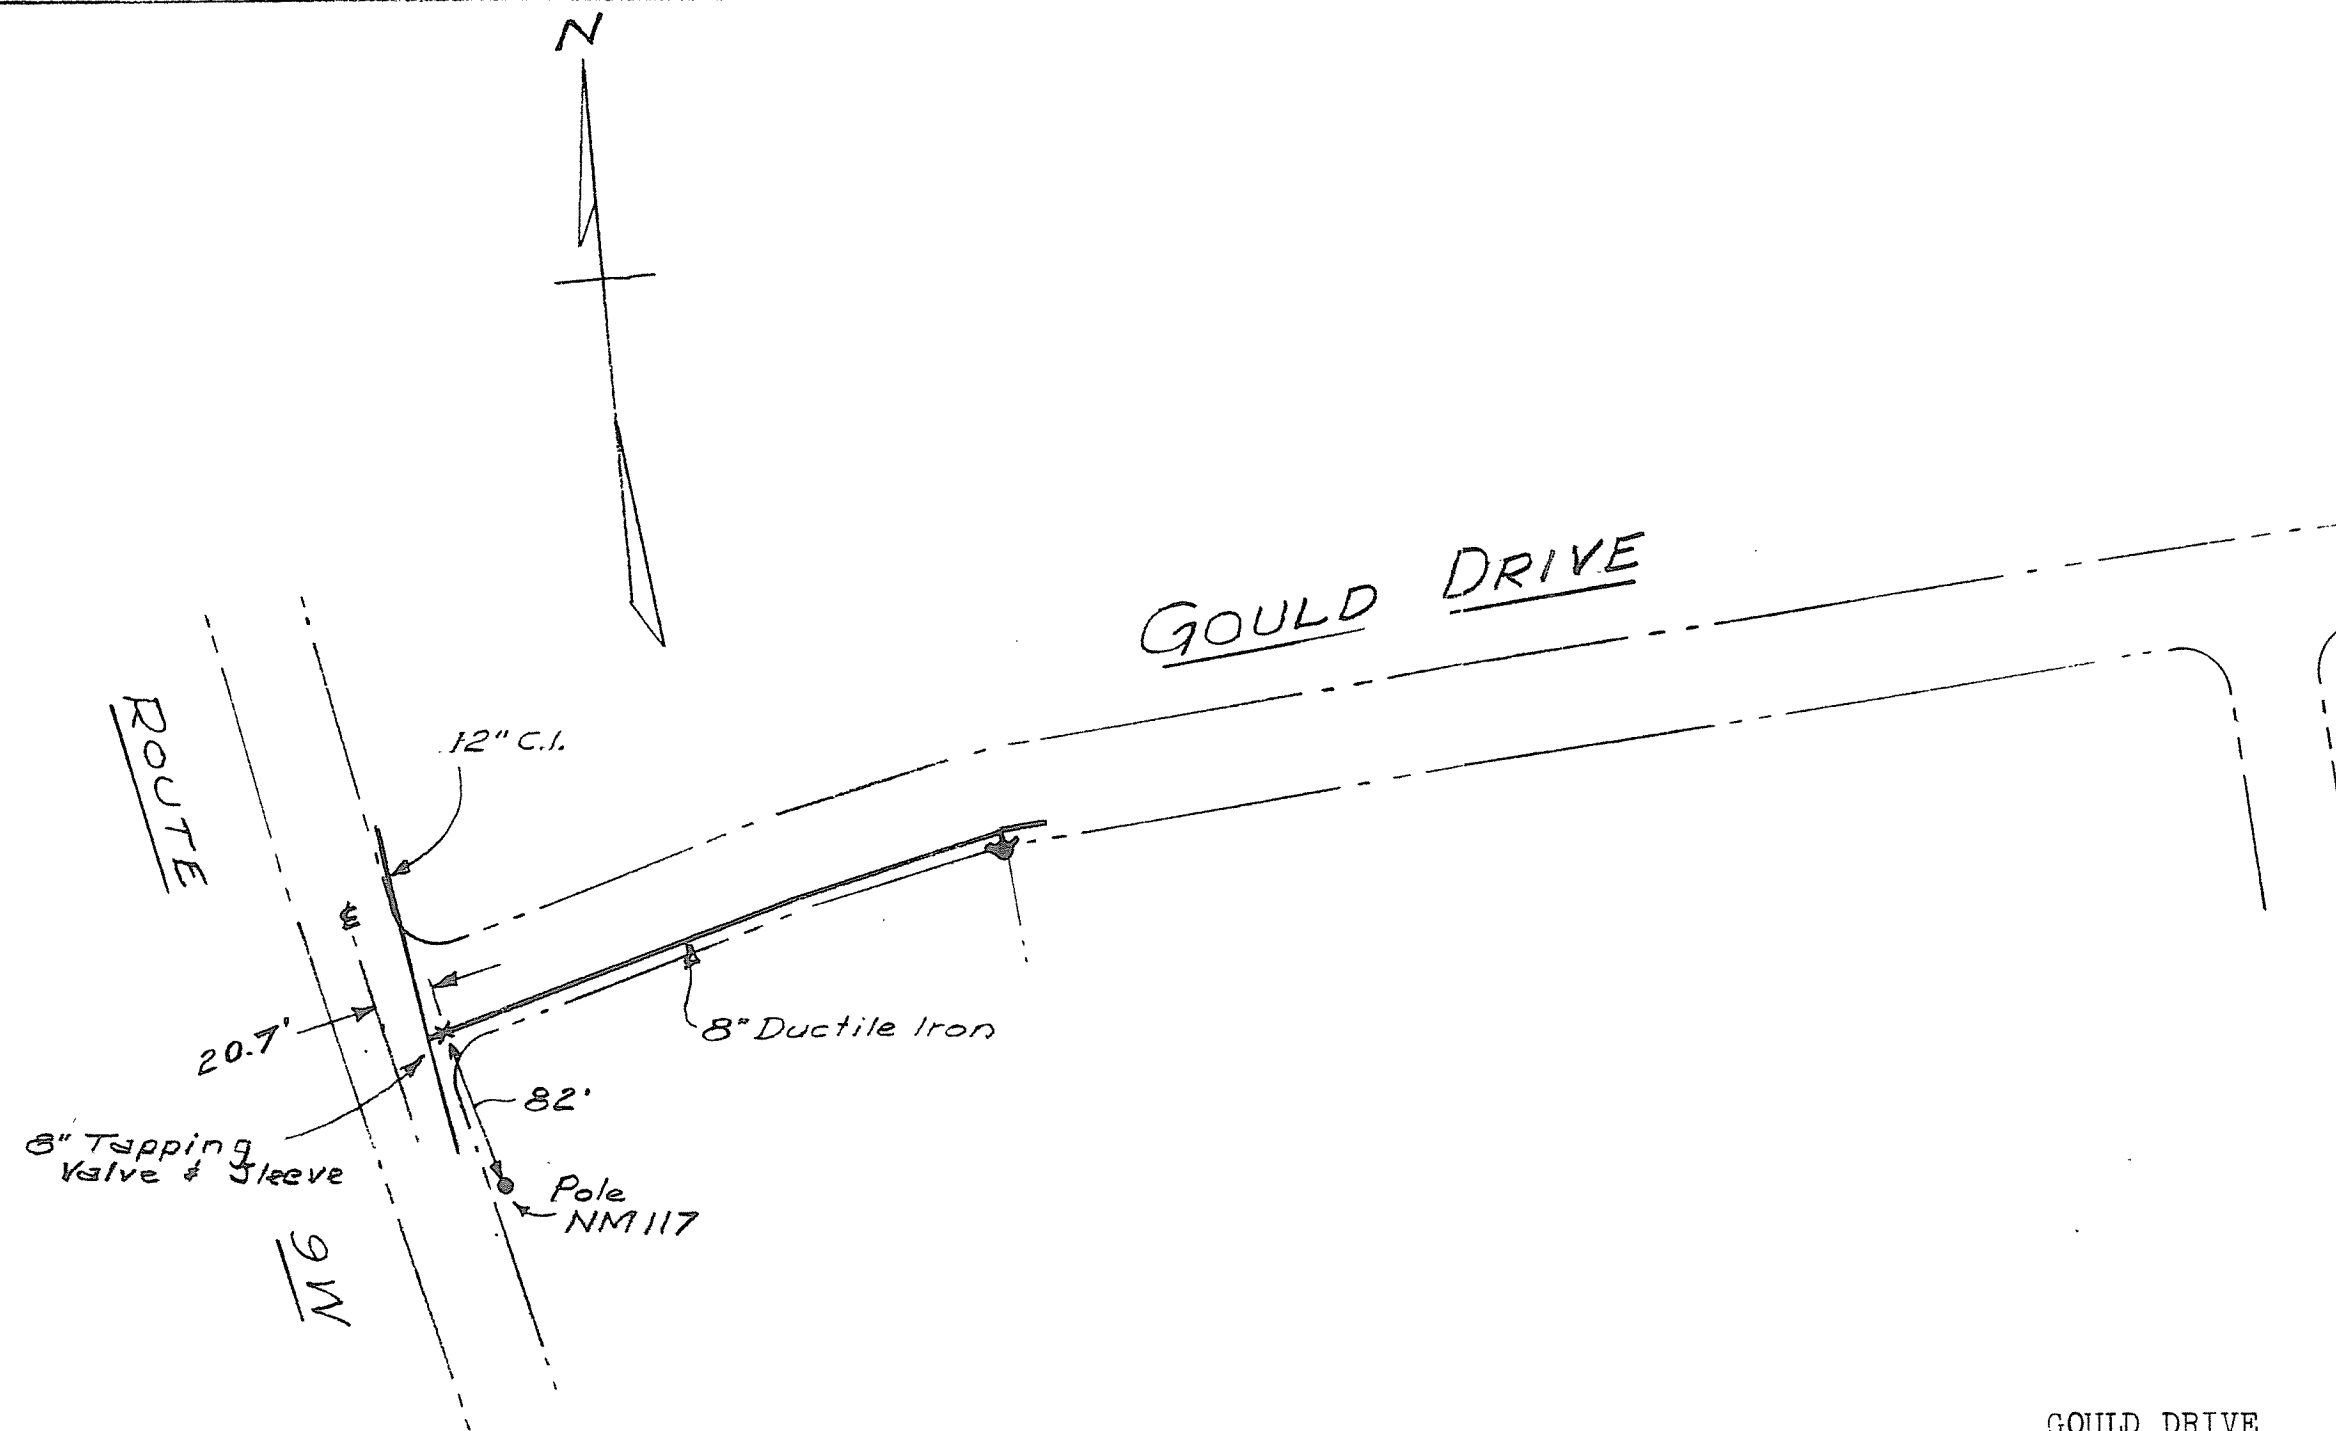

GOULD DRIVE
 WATER DISTRICT NO. 1
 TOWN OF BETHLEHEM
 RECORD OF INSTALLATION
 Scale: 1"=100' Jan. 1976
 J. Kenneth Fraser & Assocs., P.C.
 Consulting Engineers Rensselaer, N. Y.