
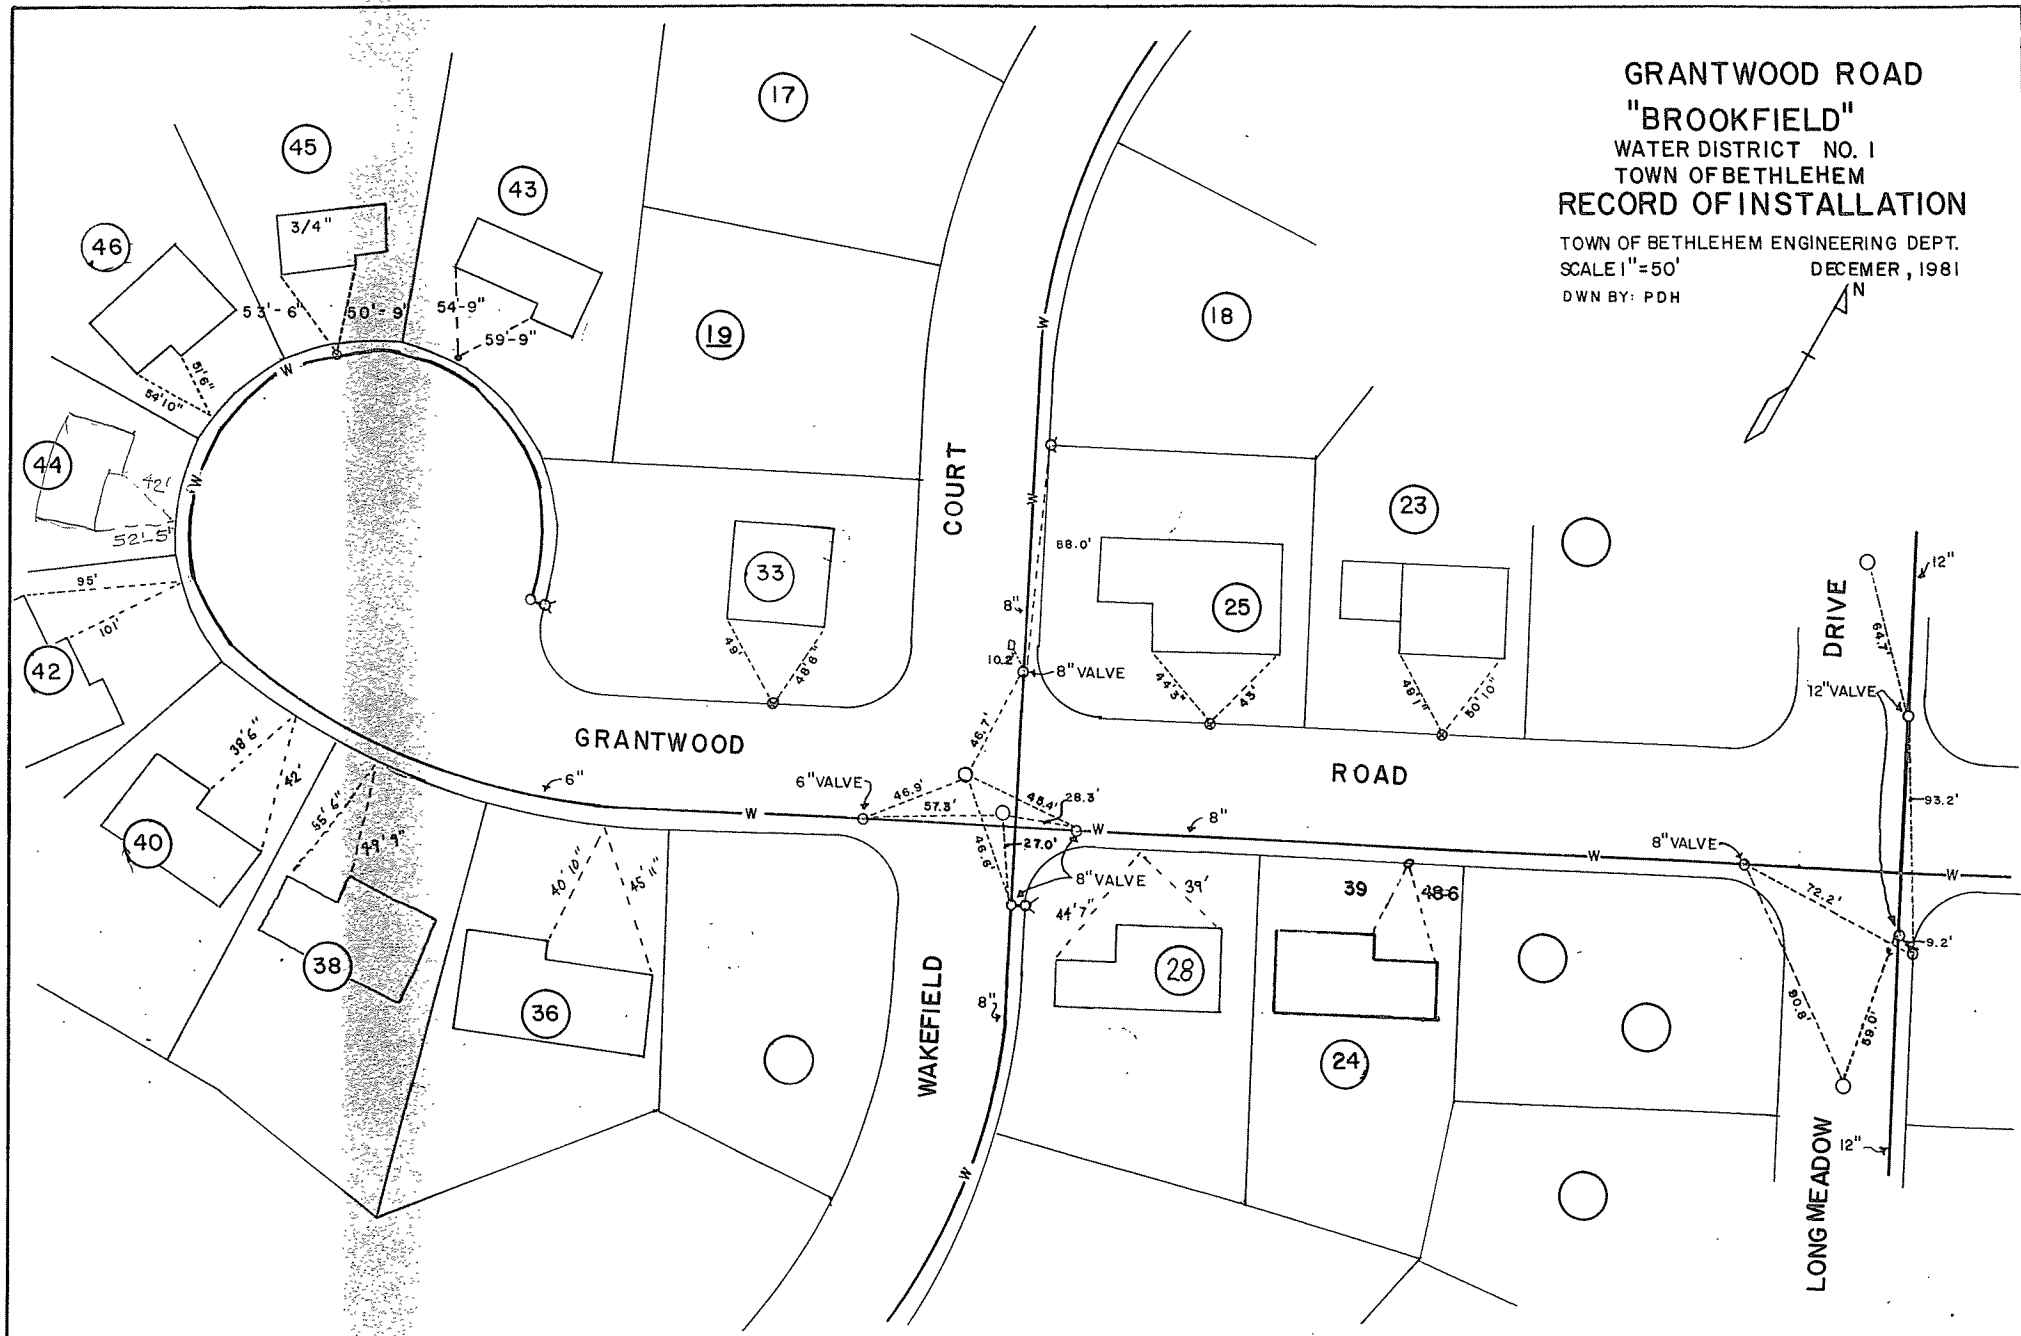


GRANTWOOD ROAD  
 "BROOKFIELD"  
 WATER DISTRICT NO. 1  
 TOWN OF BETHLEHEM  
 RECORD OF INSTALLATION

TOWN OF BETHLEHEM ENGINEERING DEPT.  
 SCALE 1"=50'  
 DWN BY: PDH  
 DECEMBER, 1981

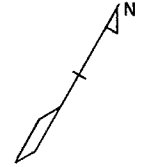

GRANTWOOD ROAD