

GRANTWOOD ROAD

WATER DISTRICT NO. 1

TOWN OF BETHLEHEM



RECORD OF INSTALLATION

TOWN OF BETHLEHEM ENGINEERING DEPARTMENT


SCALE : 1" = 50'

JUNE, 1984


DRAWN BY: KT

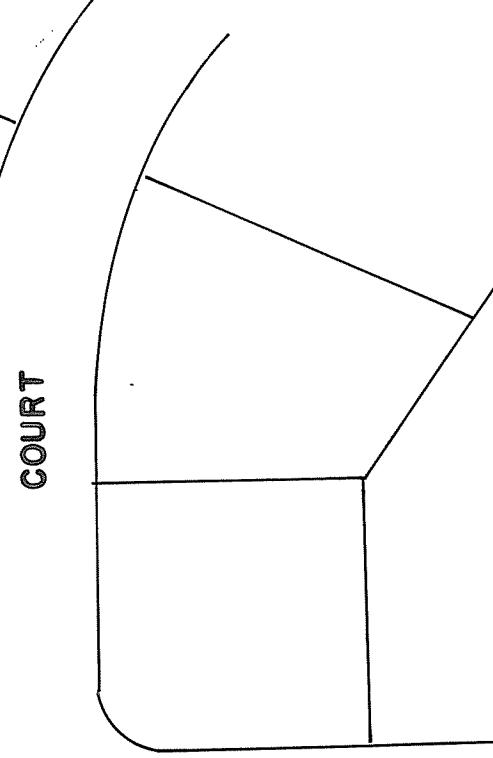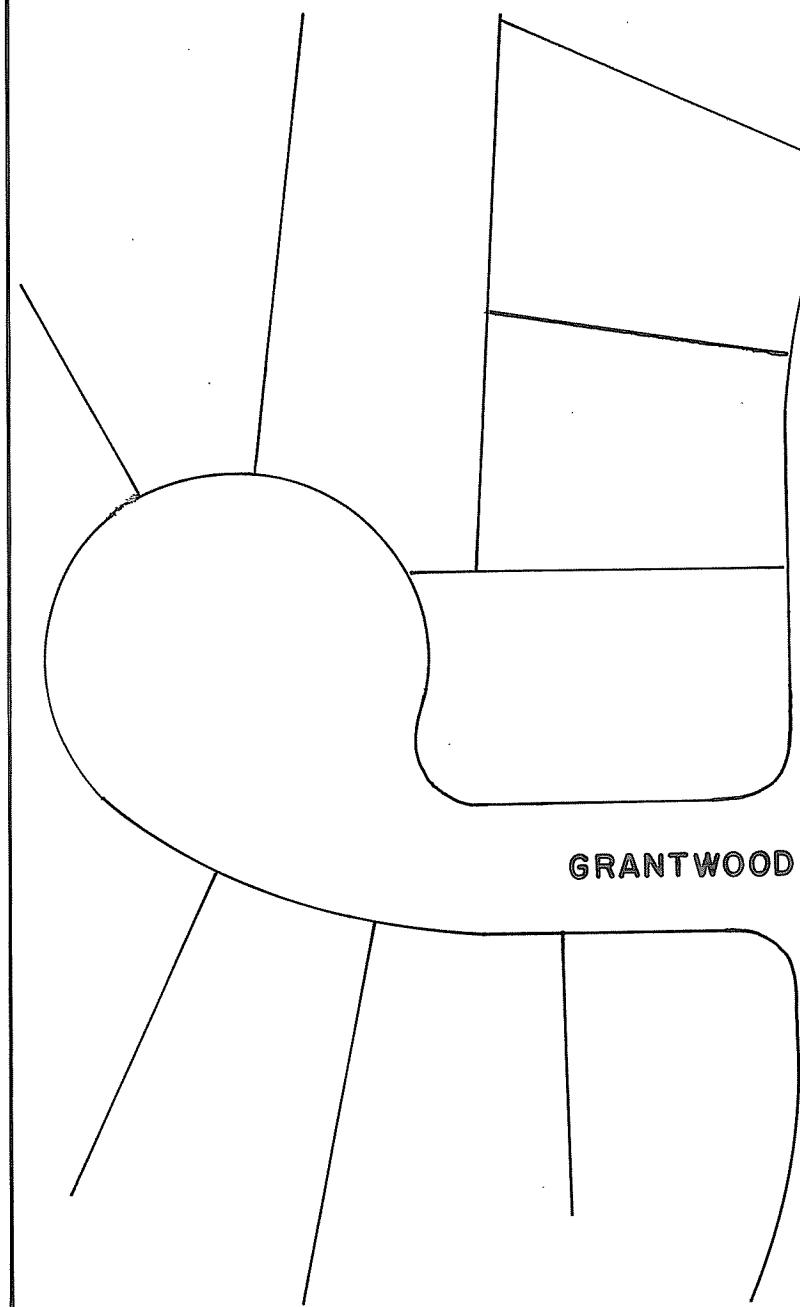

WAKEFIELD

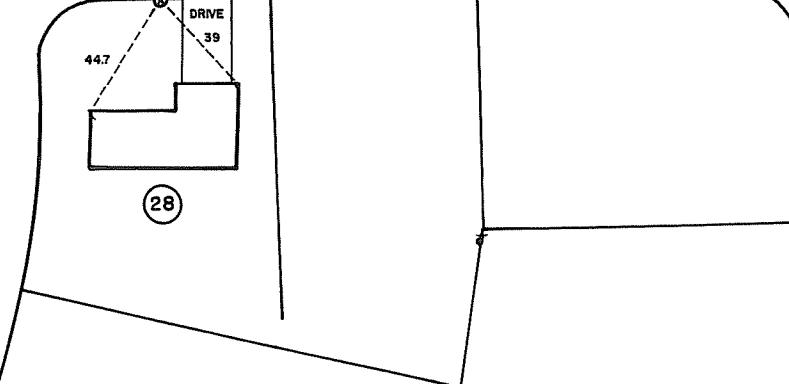

ROAD

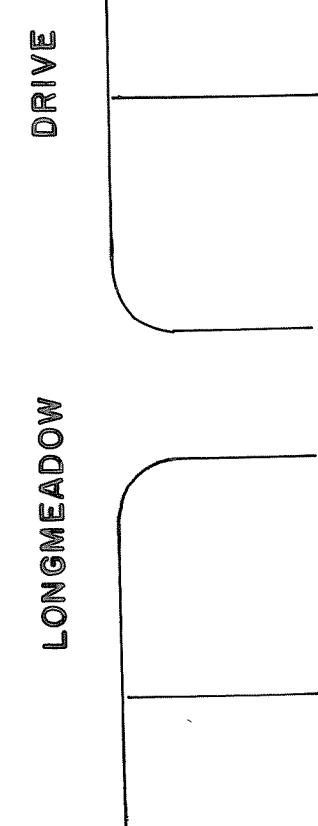

LONGMEADOW