


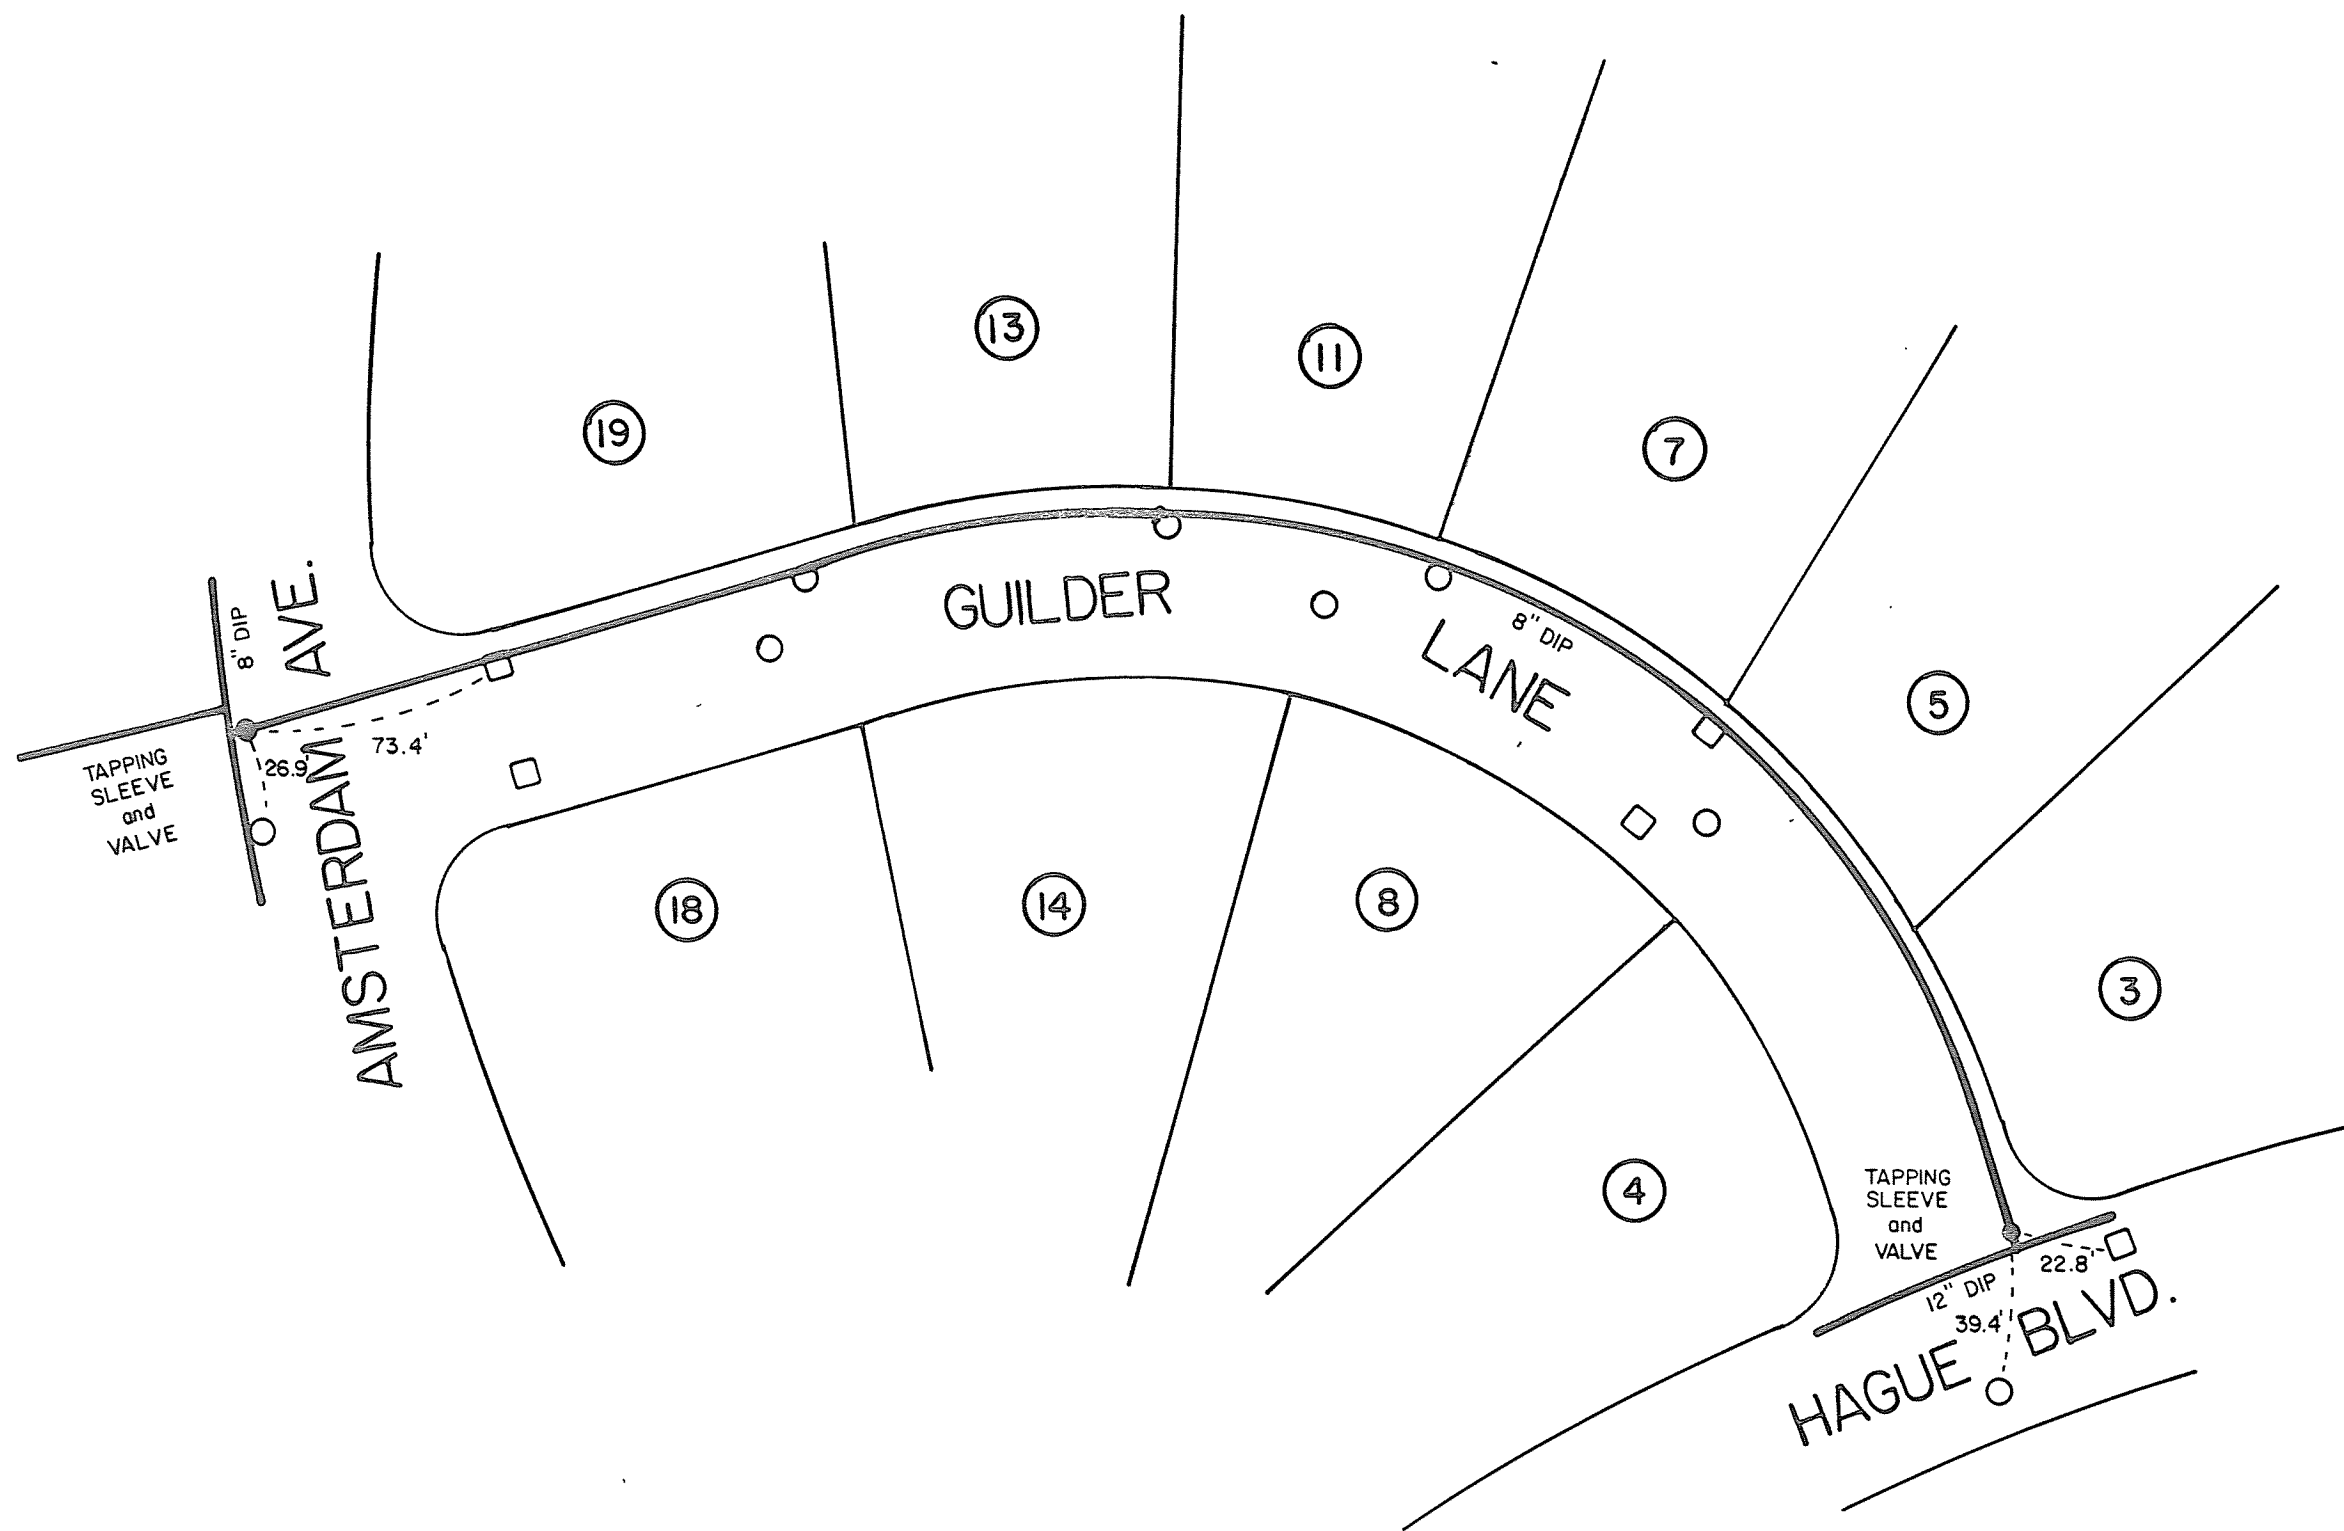

**GUILDER LANE  
WATER MAIN**

SEPTEMBER 1989  
1" = 50'

GUILDER LANE  
WATER MAIN