


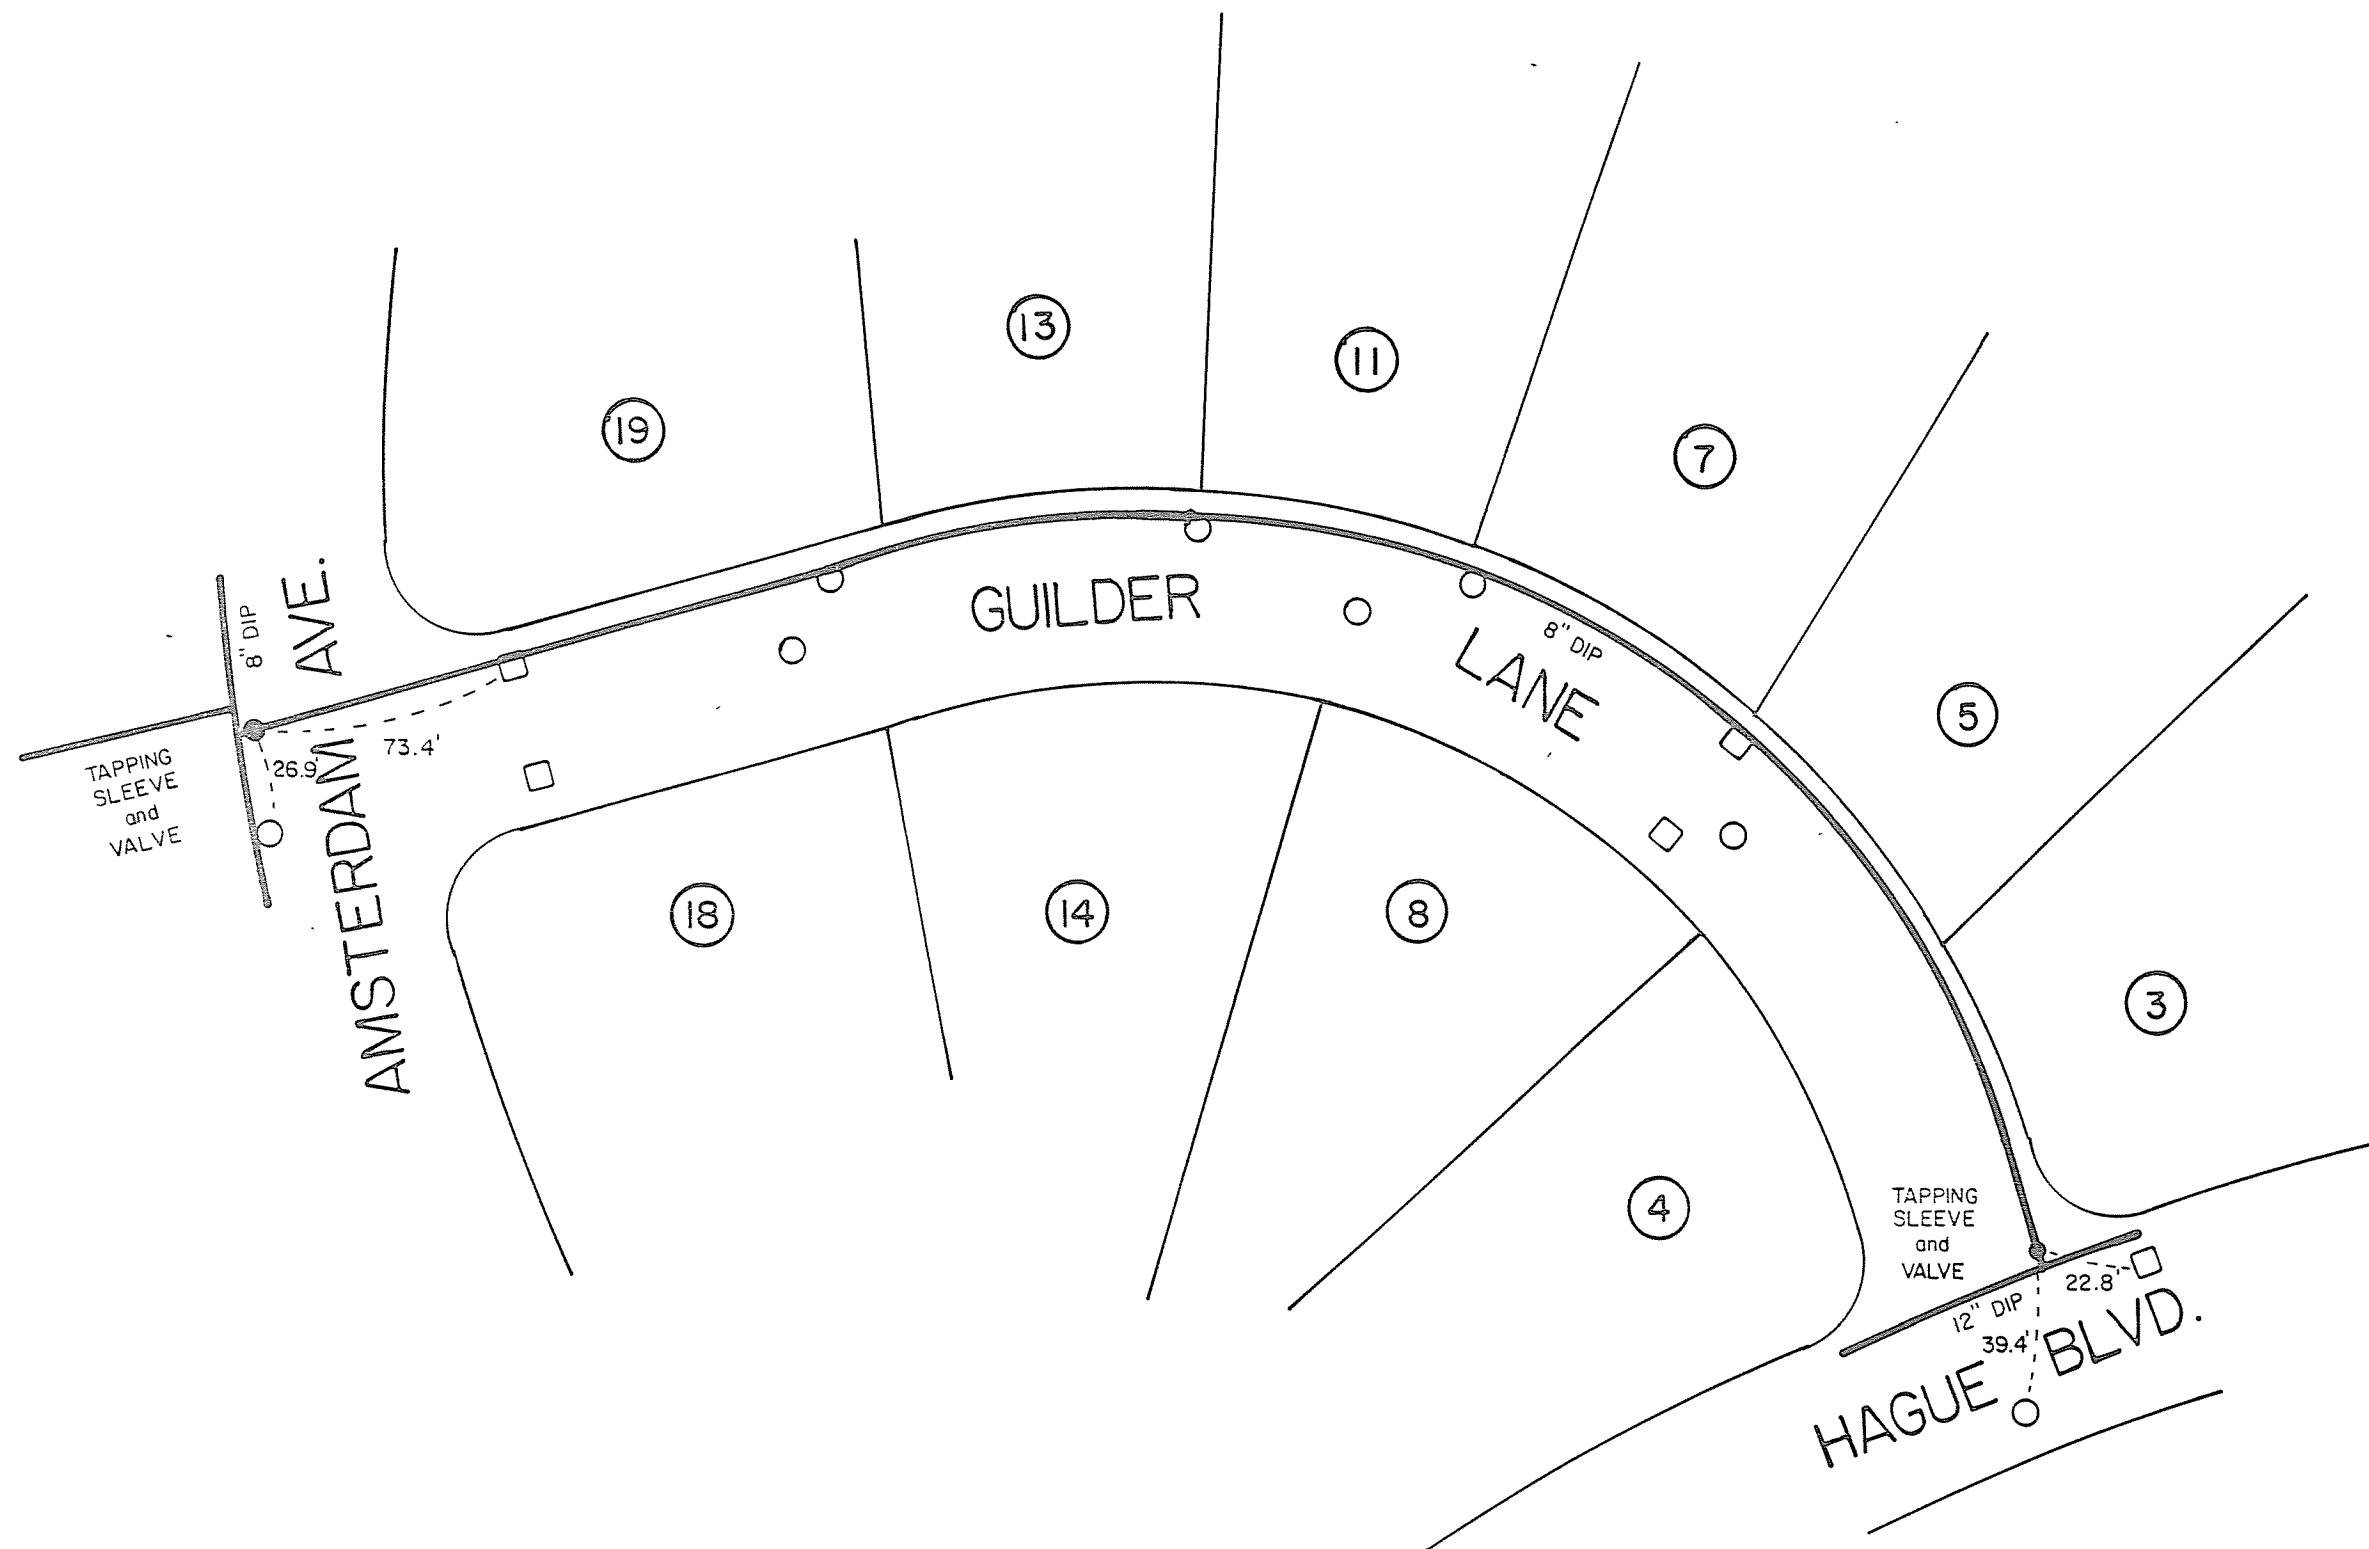

GUILDER LANE
WATER MAIN

SEPTEMBER 1989
1" = 50'