


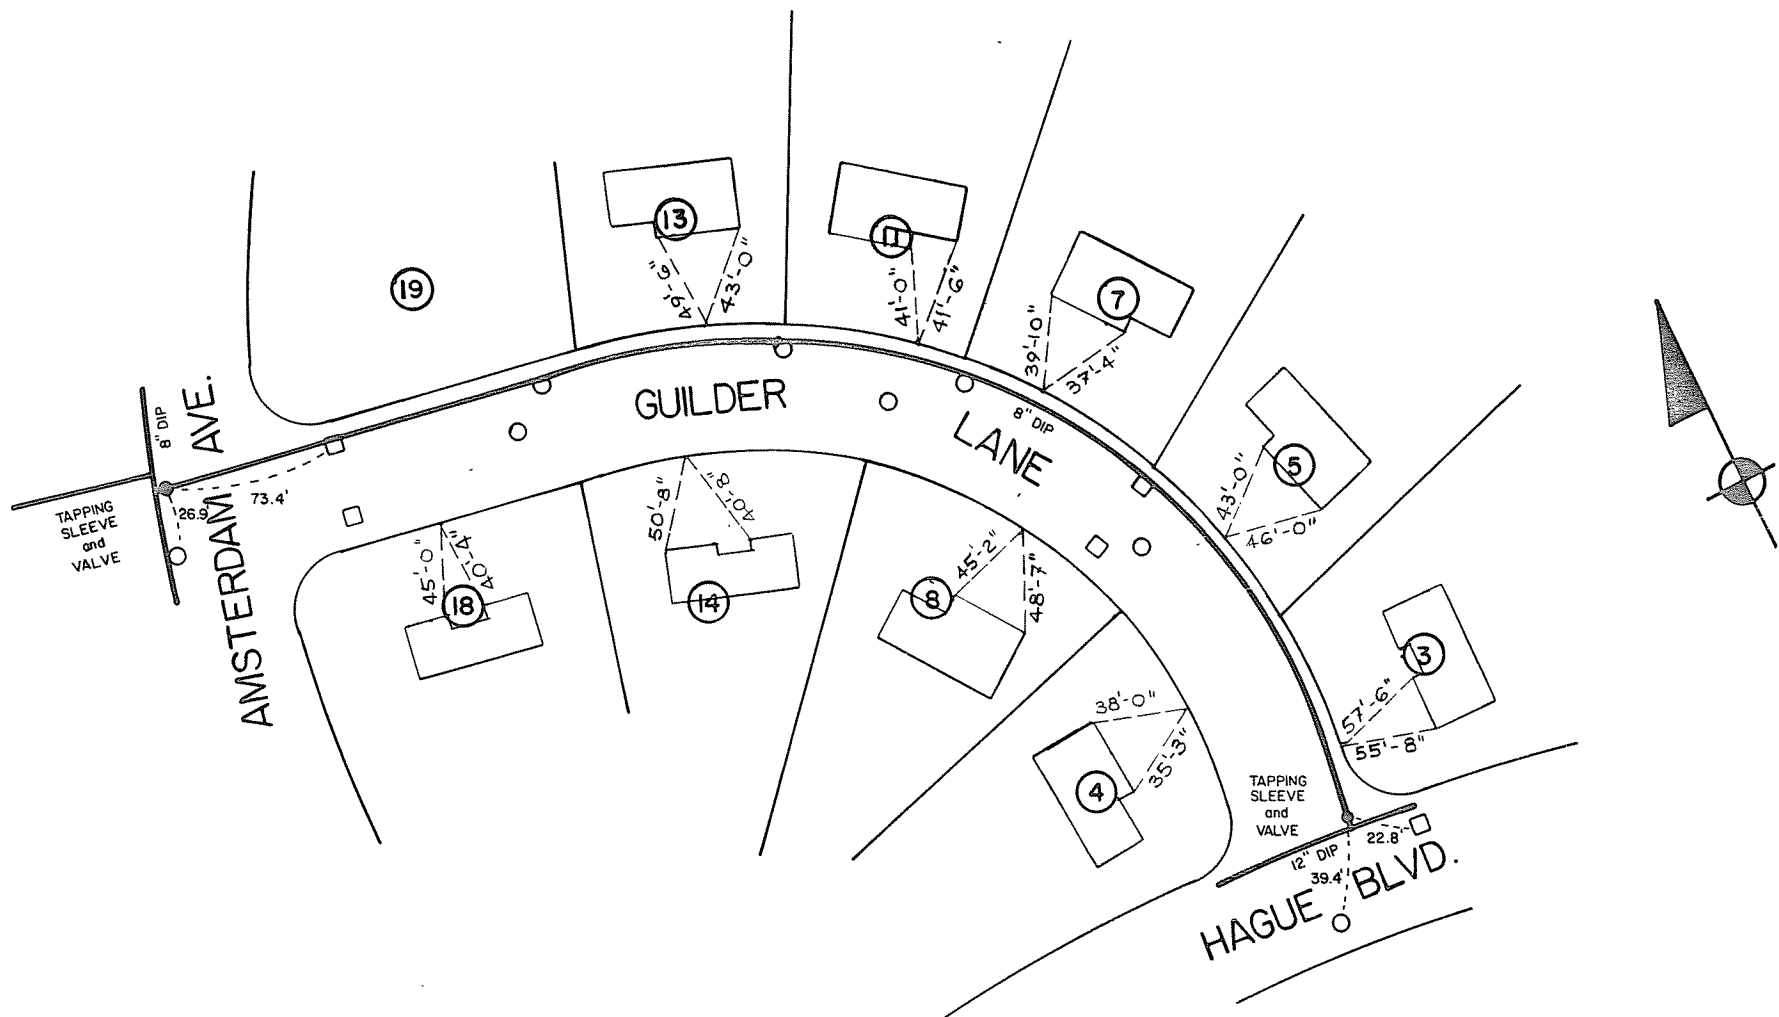

**GUILDER LANE  
WATER MAIN & CURB  
BOXES**  
SEPTEMBER 1989  
1" = 50'