


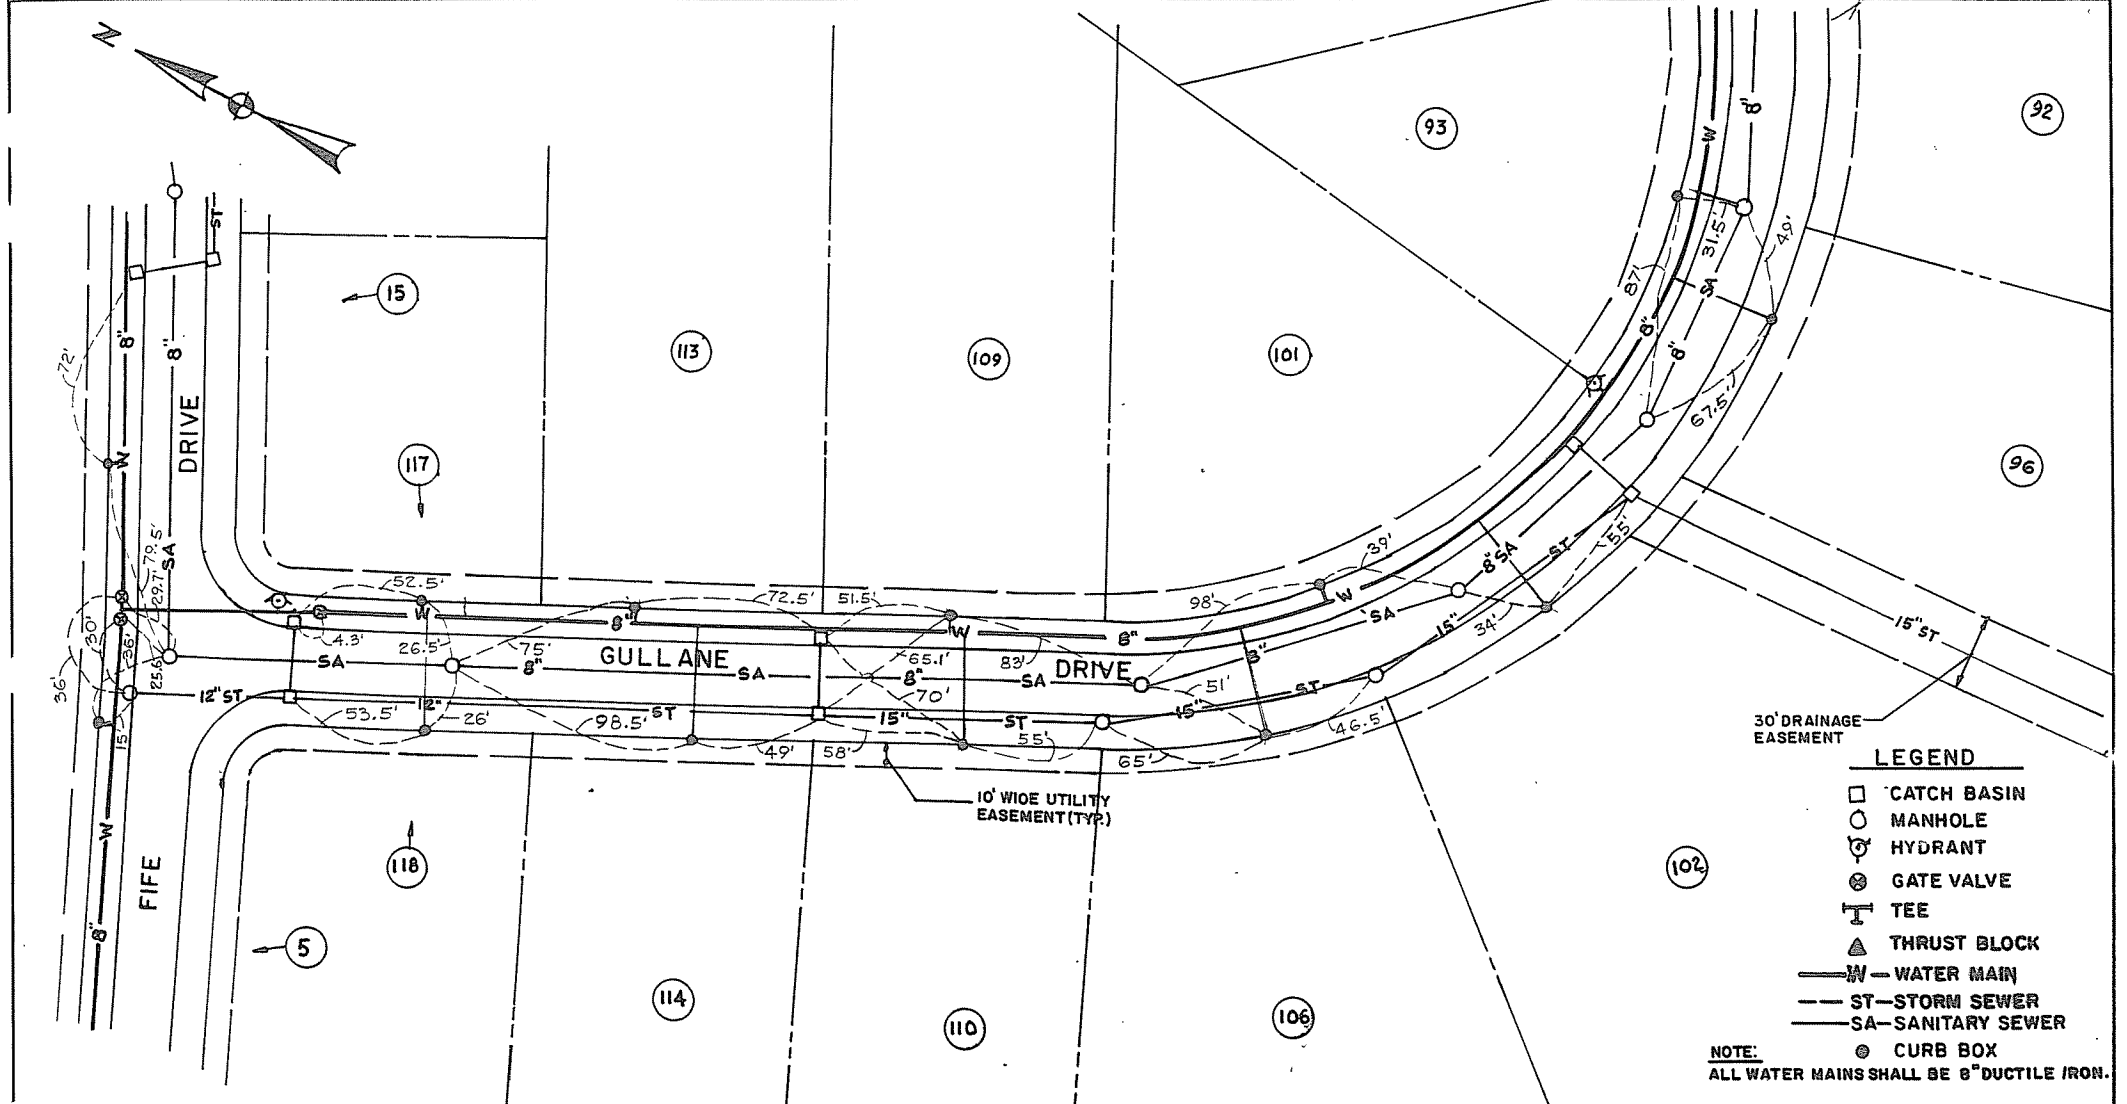

- LEGEND**
- CATCH BASIN
 - MANHOLE
 - ⊕ HYDRANT
 - ⊗ GATE VALVE
 - ⊥ TEE
 - ▲ THRUST BLOCK
 - W — WATER MAIN
 - ST --- STORM SEWER
 - SA --- SANITARY SEWER
 - ⊙ CURB BOX
- NOTE:**
ALL WATER MAINS SHALL BE 8" DUCTILE IRON.

COUNTY ALBANY	GULLANE DRIVE CEDAR RIDGE PHASE 4 WATER MAIN	STATE NEW YORK
DATE SEPT. 1997		SCALE 1" = 50'
REVISION	 TOWN OF BETHLEHEM ENGINEERING DIVISION 445 Delaware Ave. Delmar, New York 12054	DRAWING NO.