



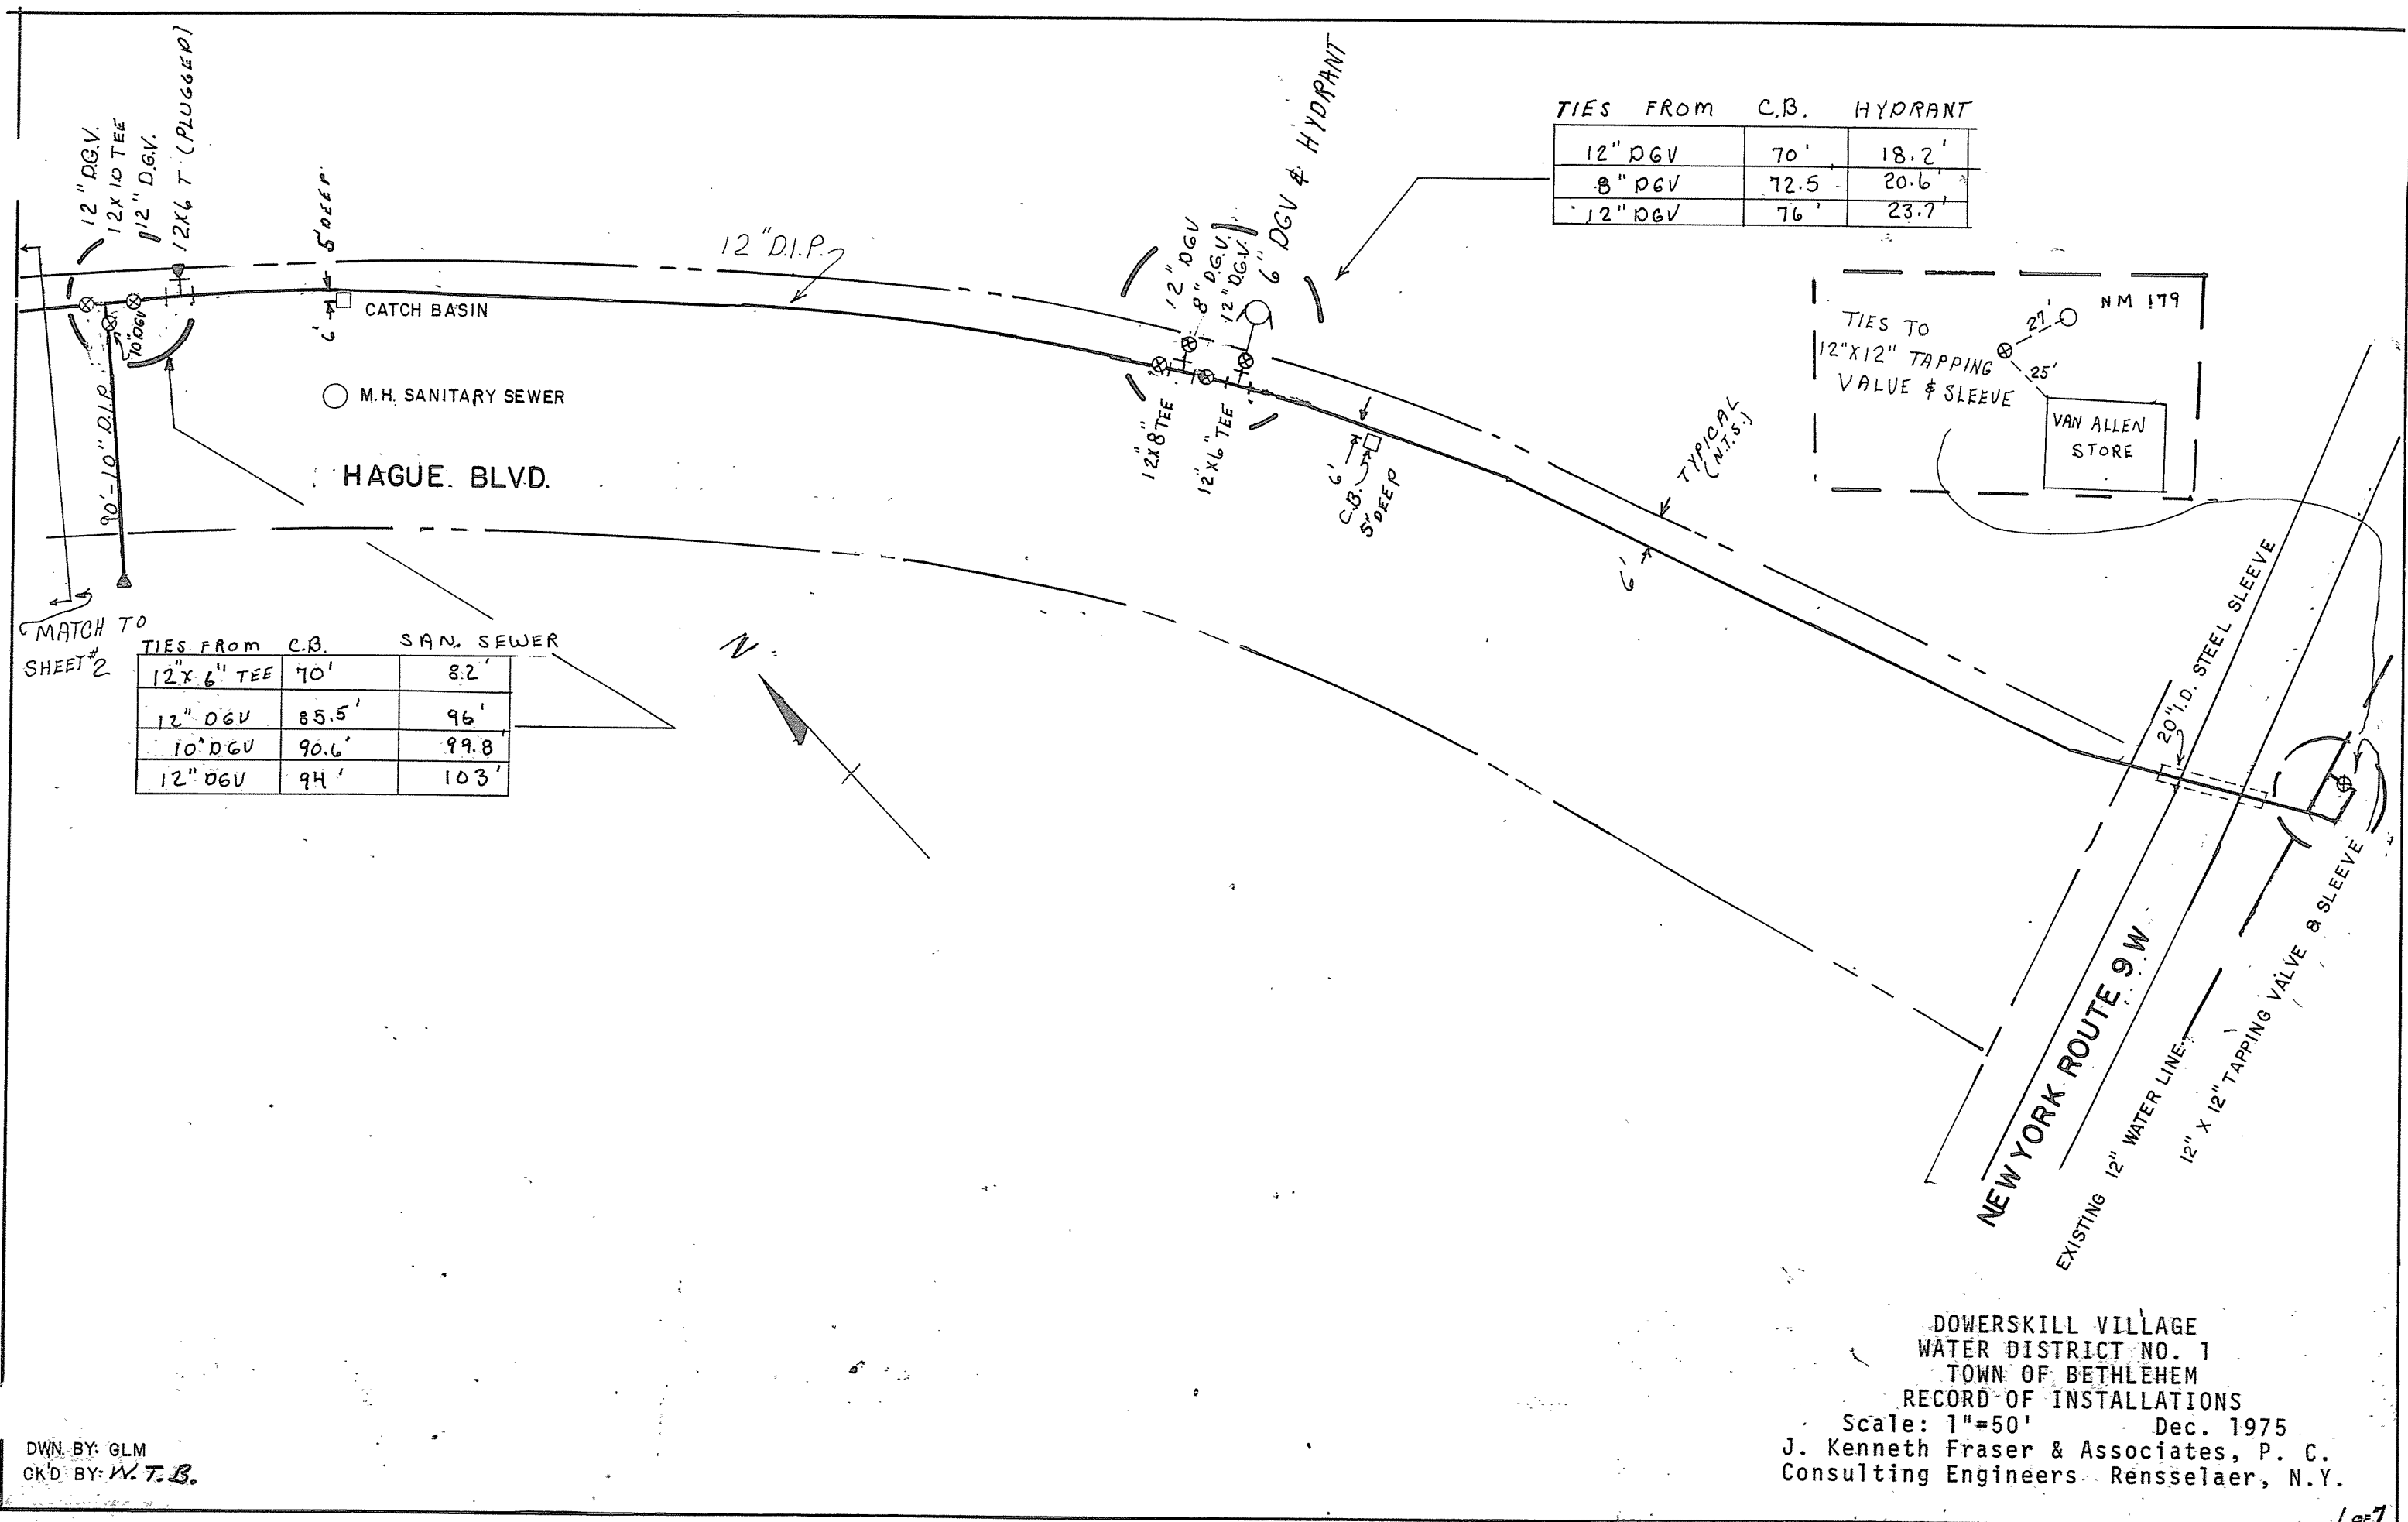

TIES FROM C.B. HYDRANT

12" DGV	70'	18.2'
8" DGV	72.5'	20.6'
12" DGV	76'	23.7'

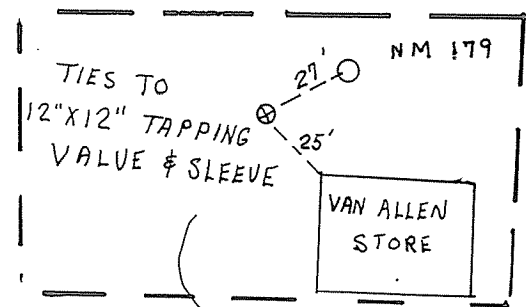

MATCH TO SHEET #2

TIES FROM C.B. SAN. SEWER

12" X 6" TEE	70'	8.2'
12" DGV	85.5'	96'
10" DGV	90.6'	99.8'
12" DGV	94'	103'

DOWERSKILL VILLAGE
 WATER DISTRICT NO. 1
 TOWN OF BETHLEHEM
 RECORD OF INSTALLATIONS
 Scale: 1"=50' Dec. 1975
 J. Kenneth Fraser & Associates, P. C.
 Consulting Engineers Rensselaer, N.Y.

DWN. BY: GLM
 CKD. BY: W. T. B.

HAGUE BLVD.