



	Hyp.	S.S.
1	22'	93.4'
2	28.3'	98.7'
3	25.0'	97.1'

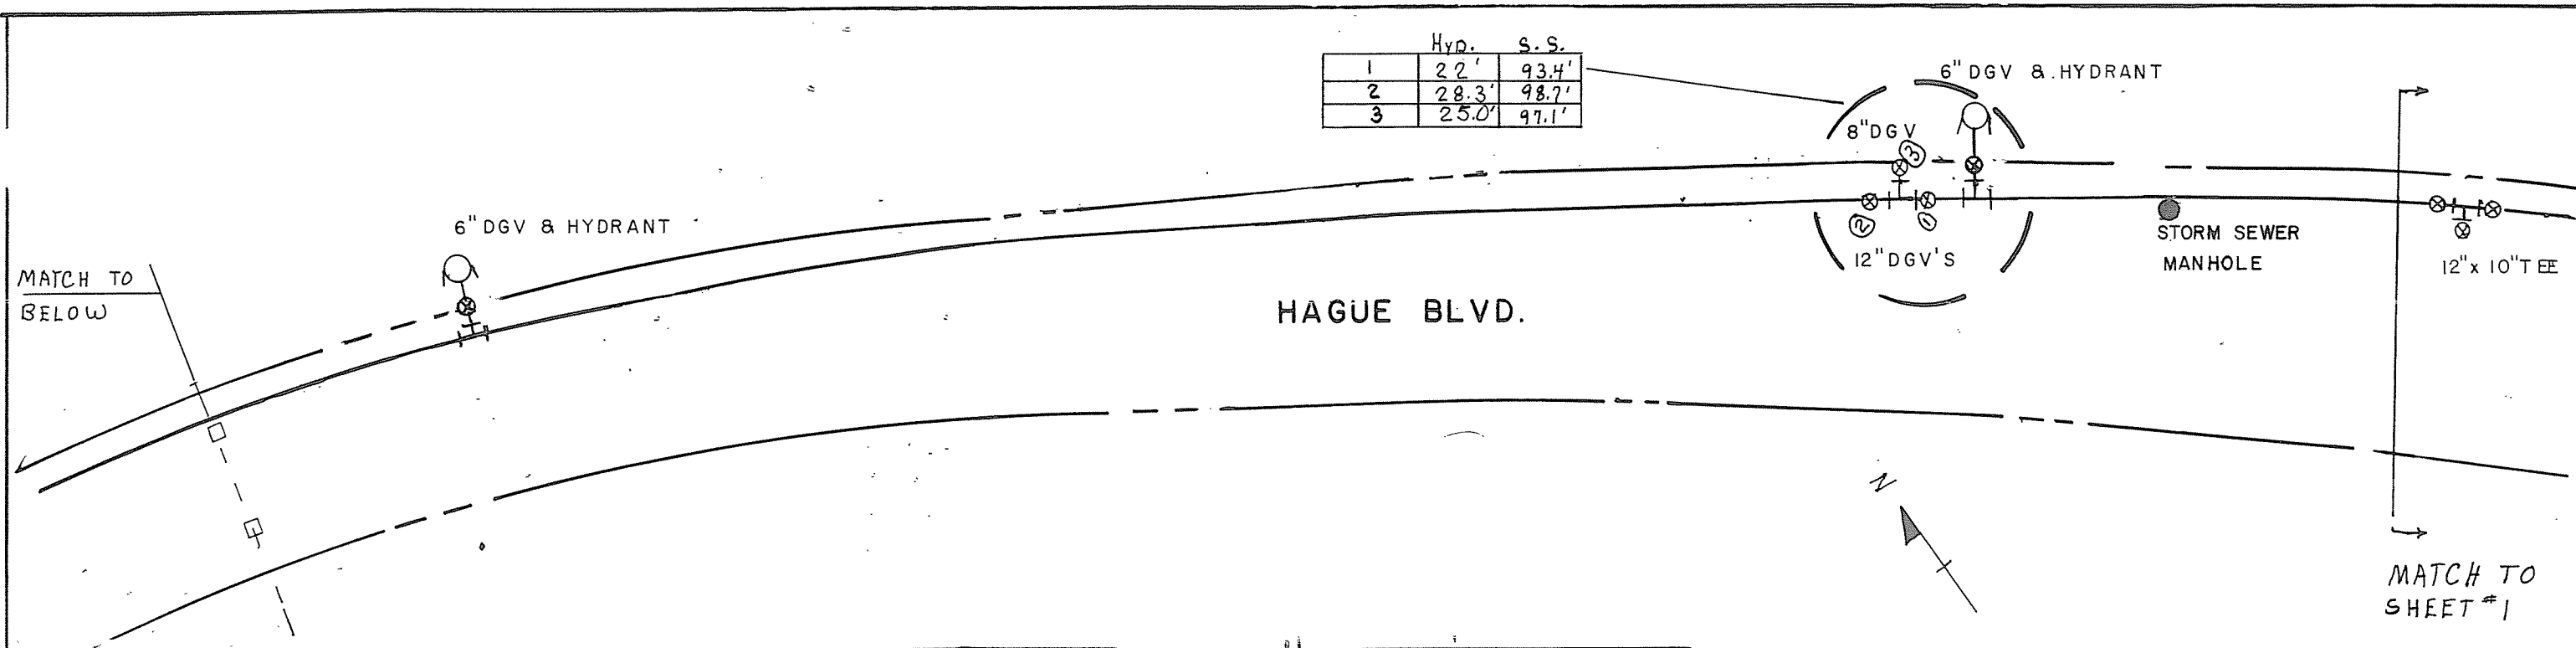

	S.S.	SANITARY
①	8.8'	27.8'
②	9.5'	31'
③	12.2'	33.4'

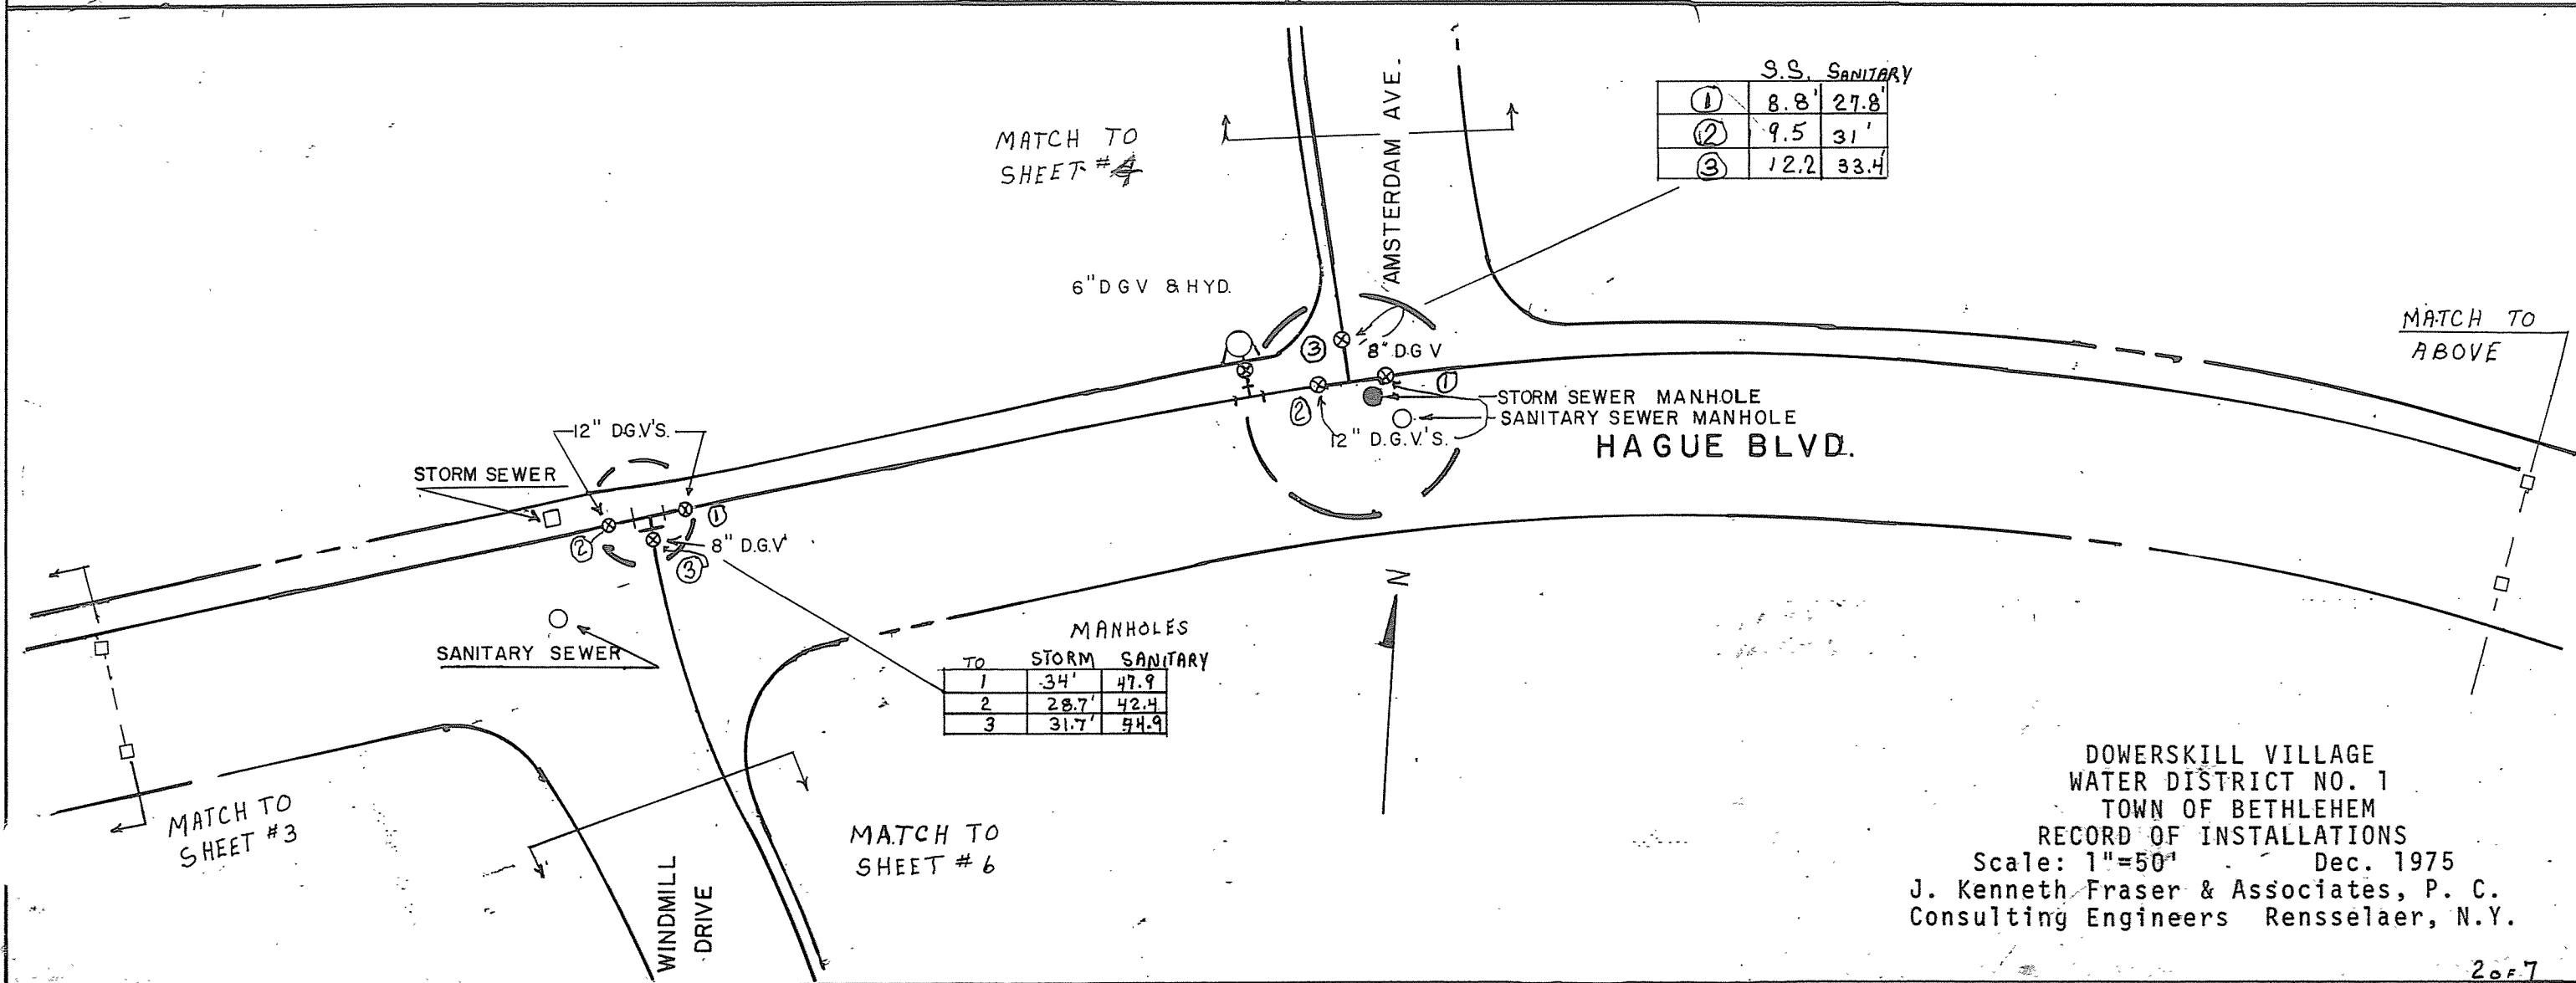

DOWERSKILL VILLAGE
 WATER DISTRICT NO. 1
 TOWN OF BETHLEHEM
 RECORD OF INSTALLATIONS
 Scale: 1"=50' Dec. 1975
 J. Kenneth Fraser & Associates, P. C.
 Consulting Engineers Rensselaer, N.Y.