


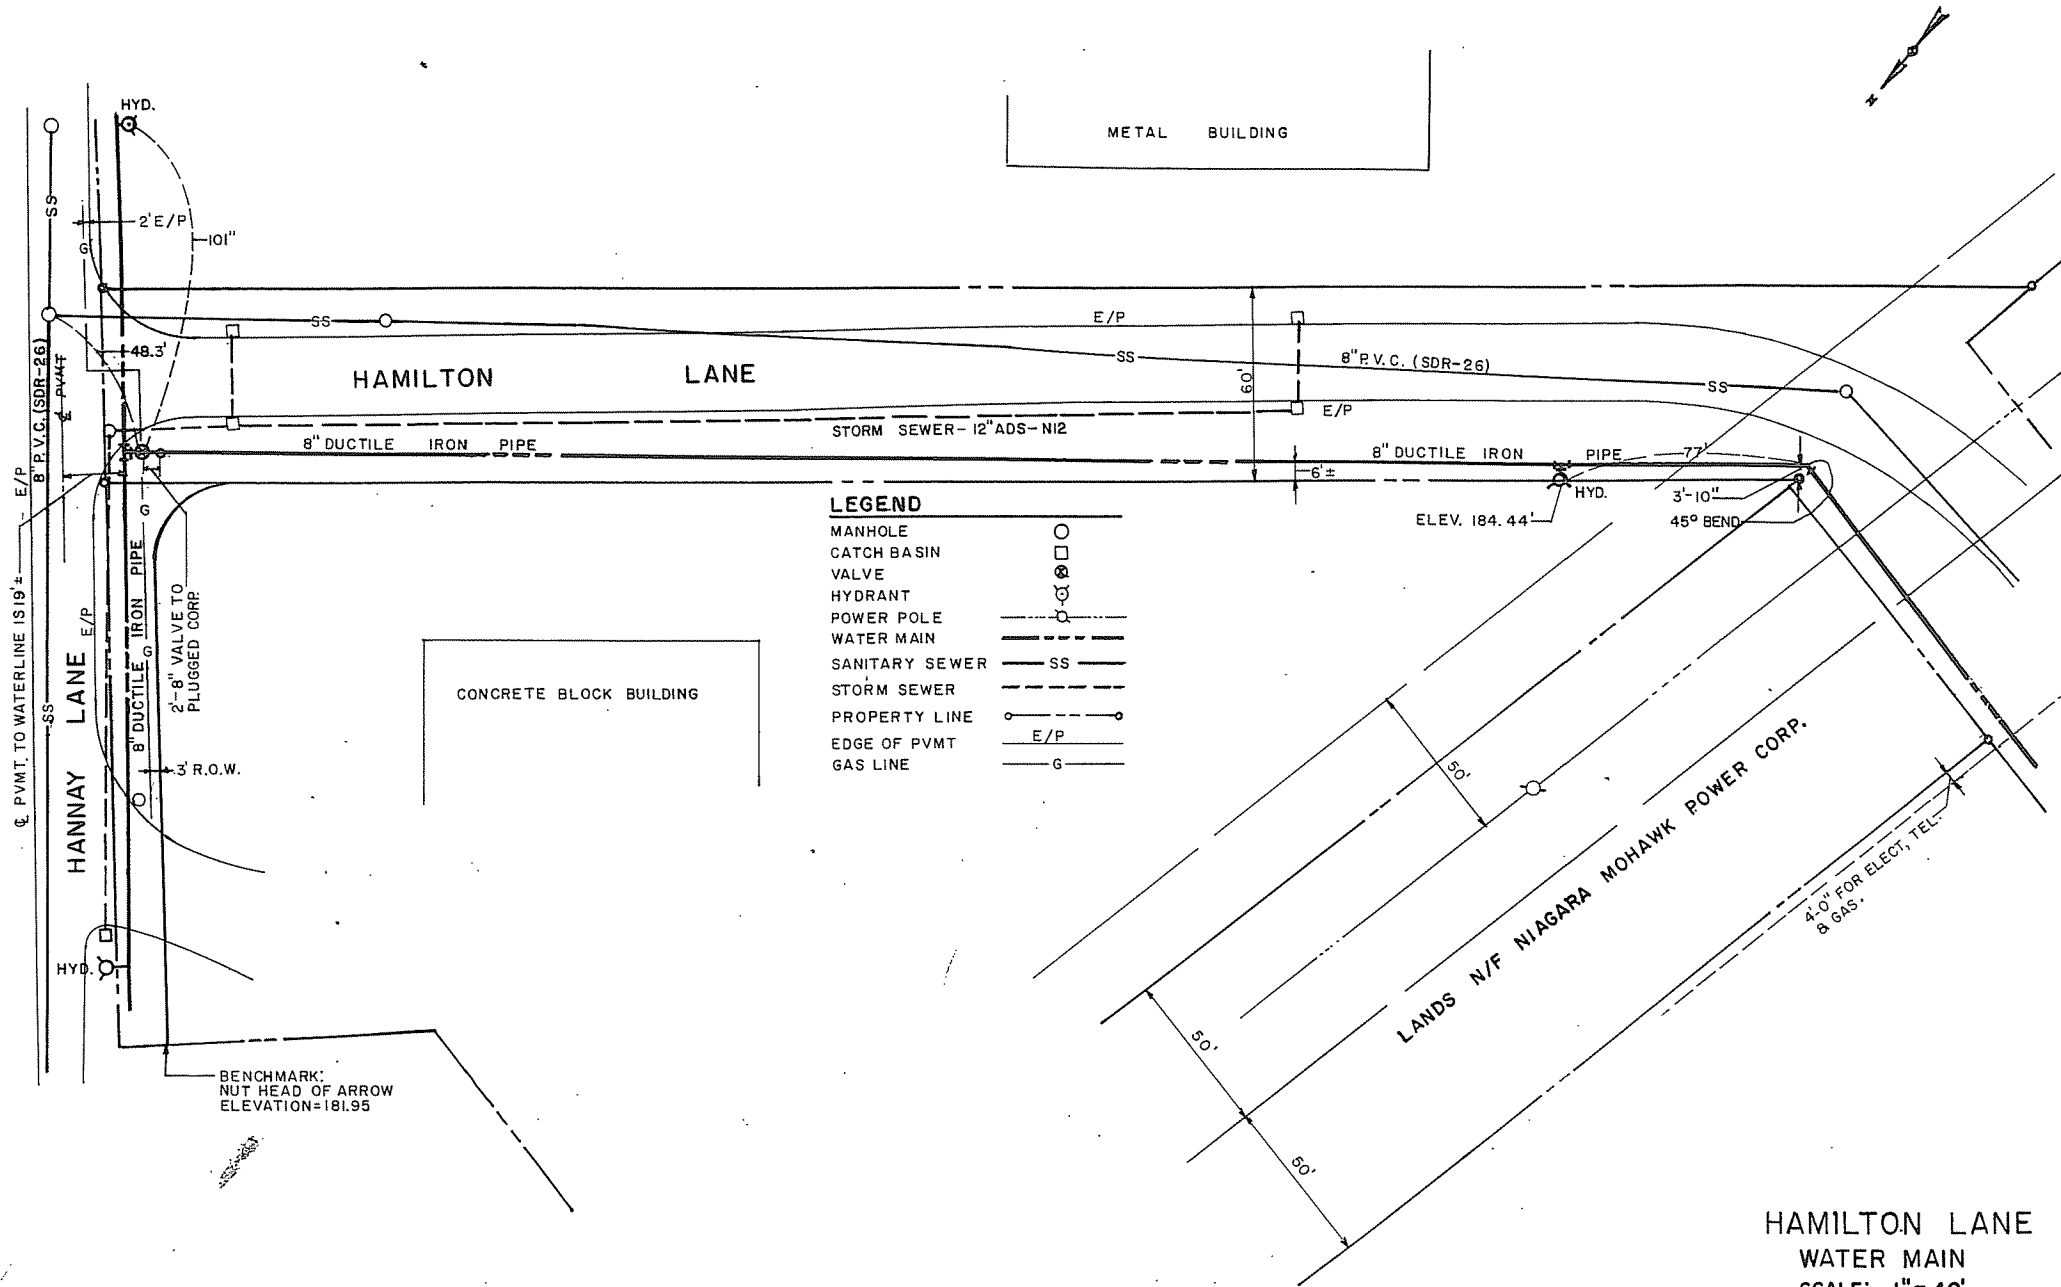

LEGEND

MANHOLE	○
CATCH BASIN	□
VALVE	⊗
HYDRANT	⊙
POWER POLE	⊕
WATER MAIN	—
SANITARY SEWER	SS
STORM SEWER	---
PROPERTY LINE	—○—
EDGE OF PVMT	E/P
GAS LINE	G

HAMILTON LANE
WATER MAIN
 SCALE: 1" = 40'
 CONTRACTOR: JOHN CERONE
 DATE: NOV. 1992