


# LEGEND

- ATCH BASIN
- MANHOLE
- ⊕ HYDRANT
- GATE VALVE
- ⊥ TEE
- ▲ TRUSS BLOCK
- WATER MAIN

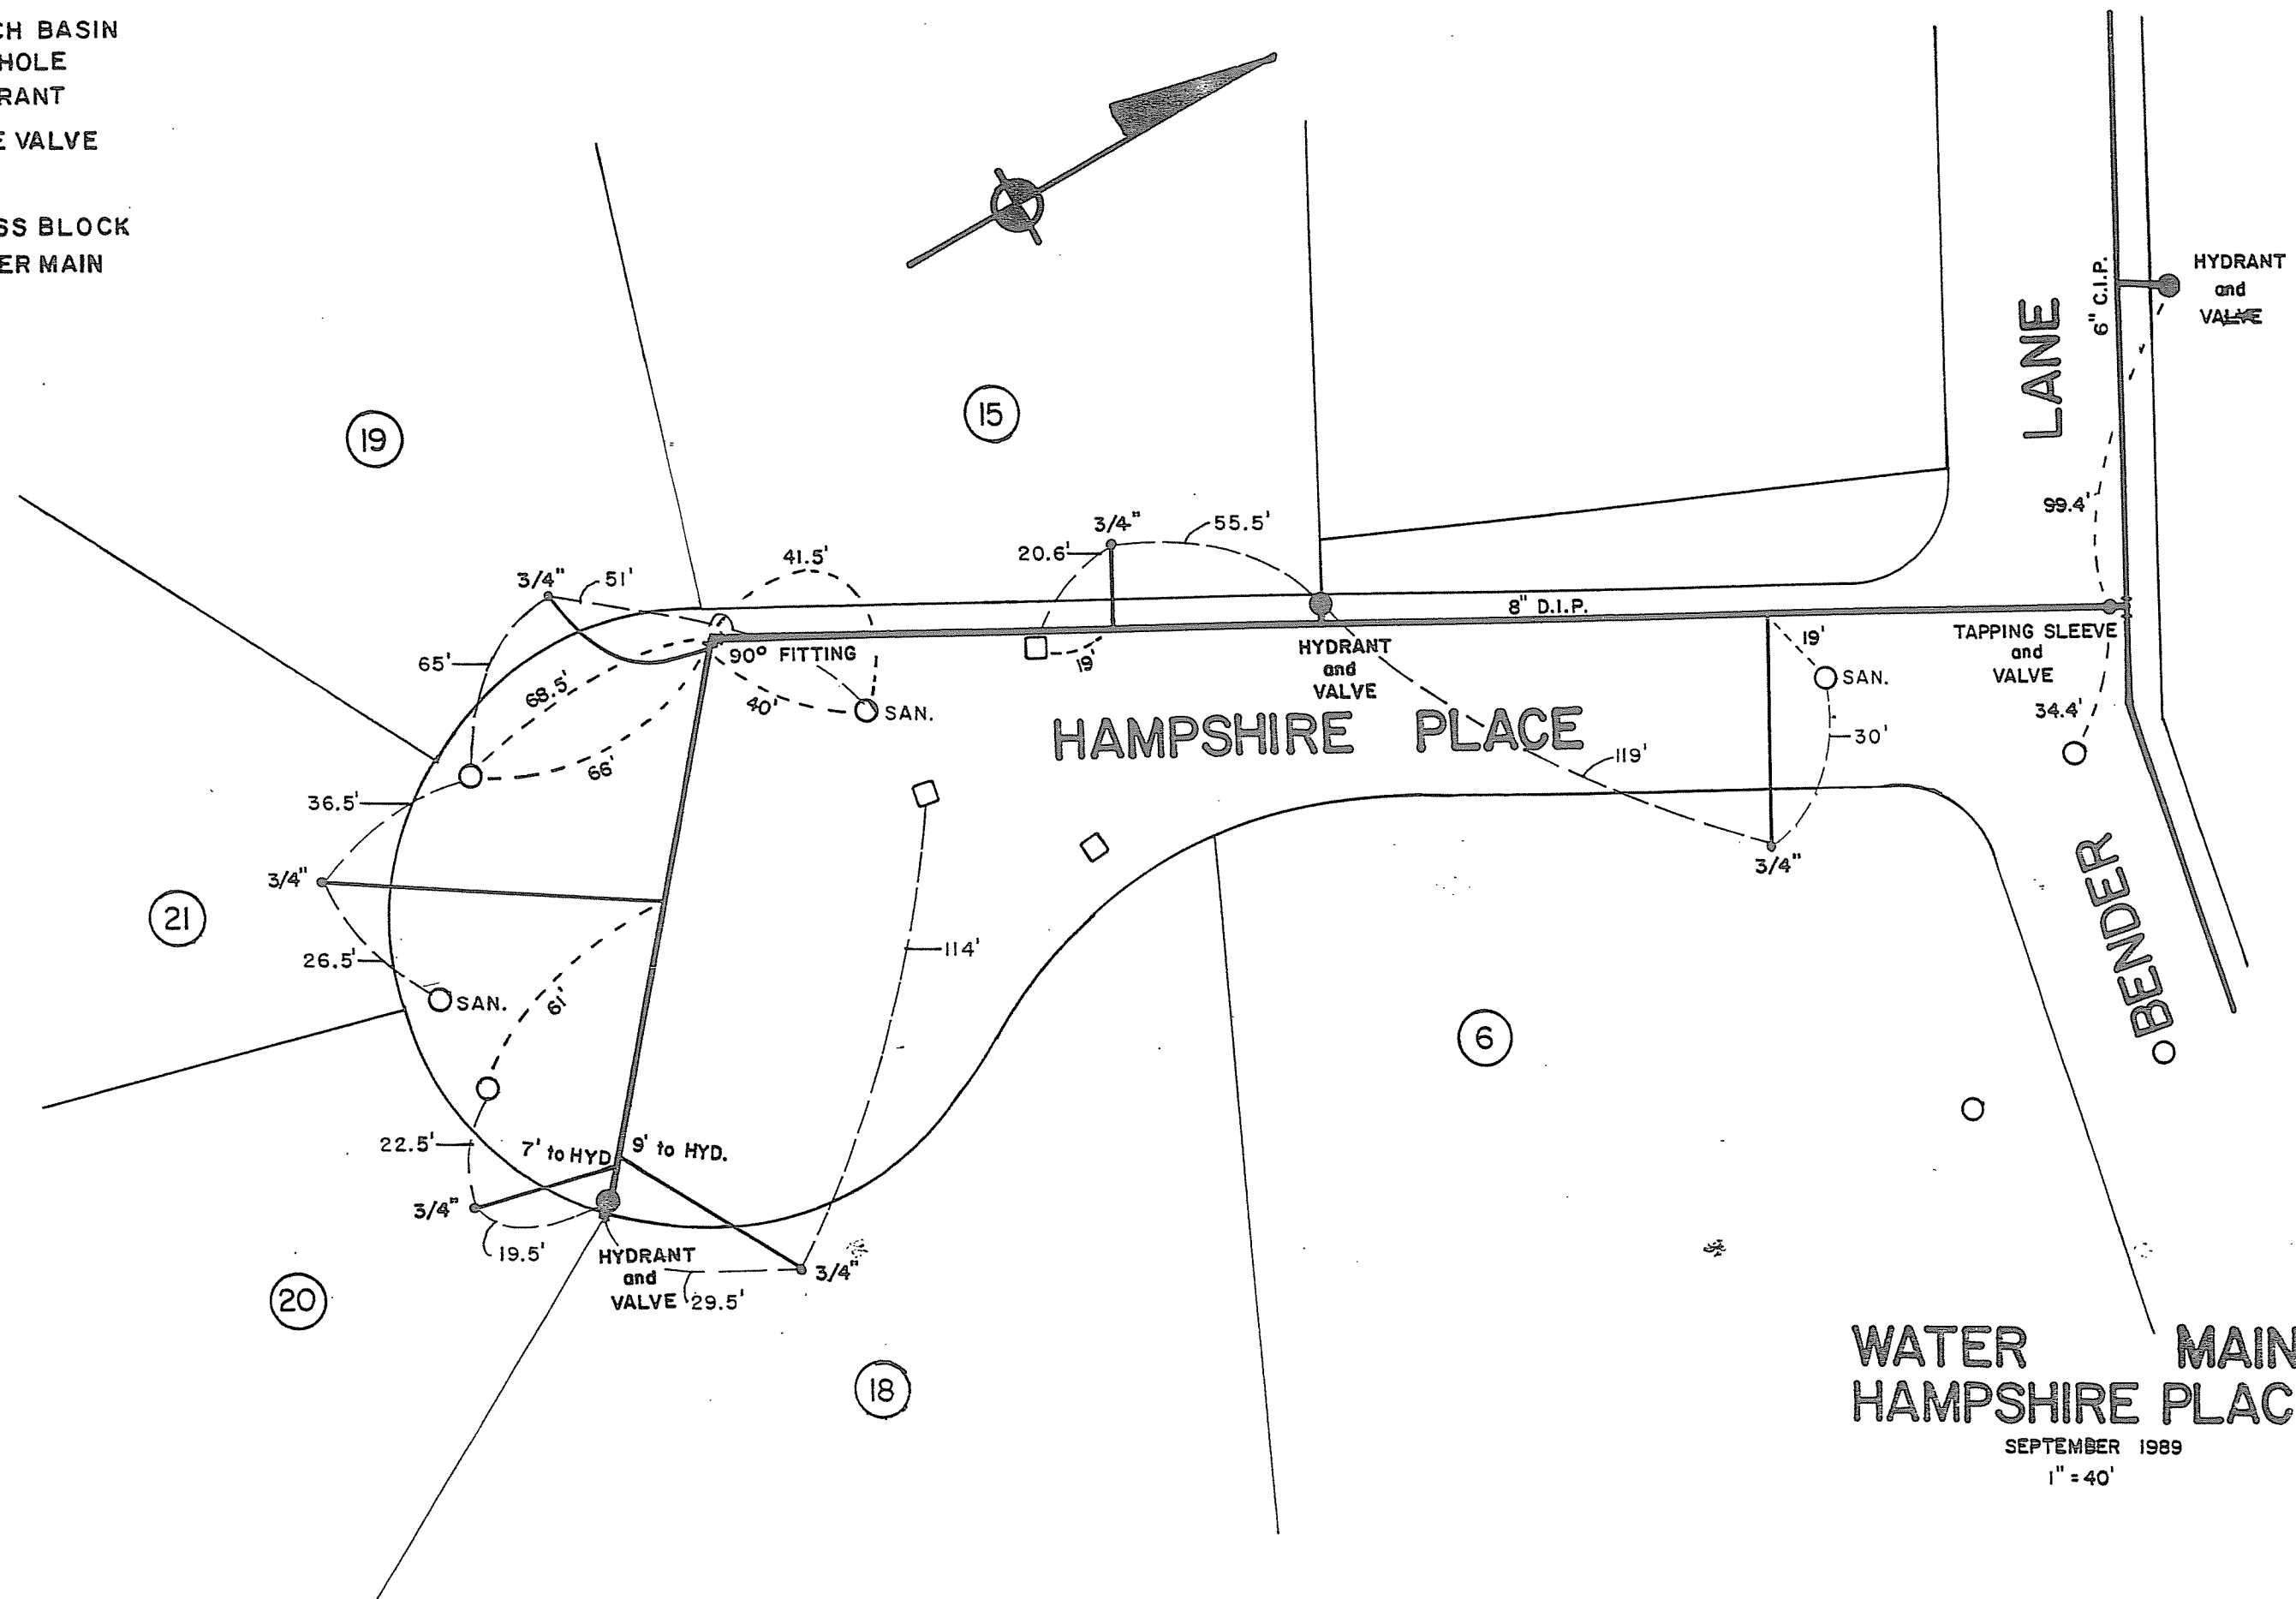

WATER MAINS  
HAMPSHIRE PLACE

SEPTEMBER 1989  
1" = 40'