


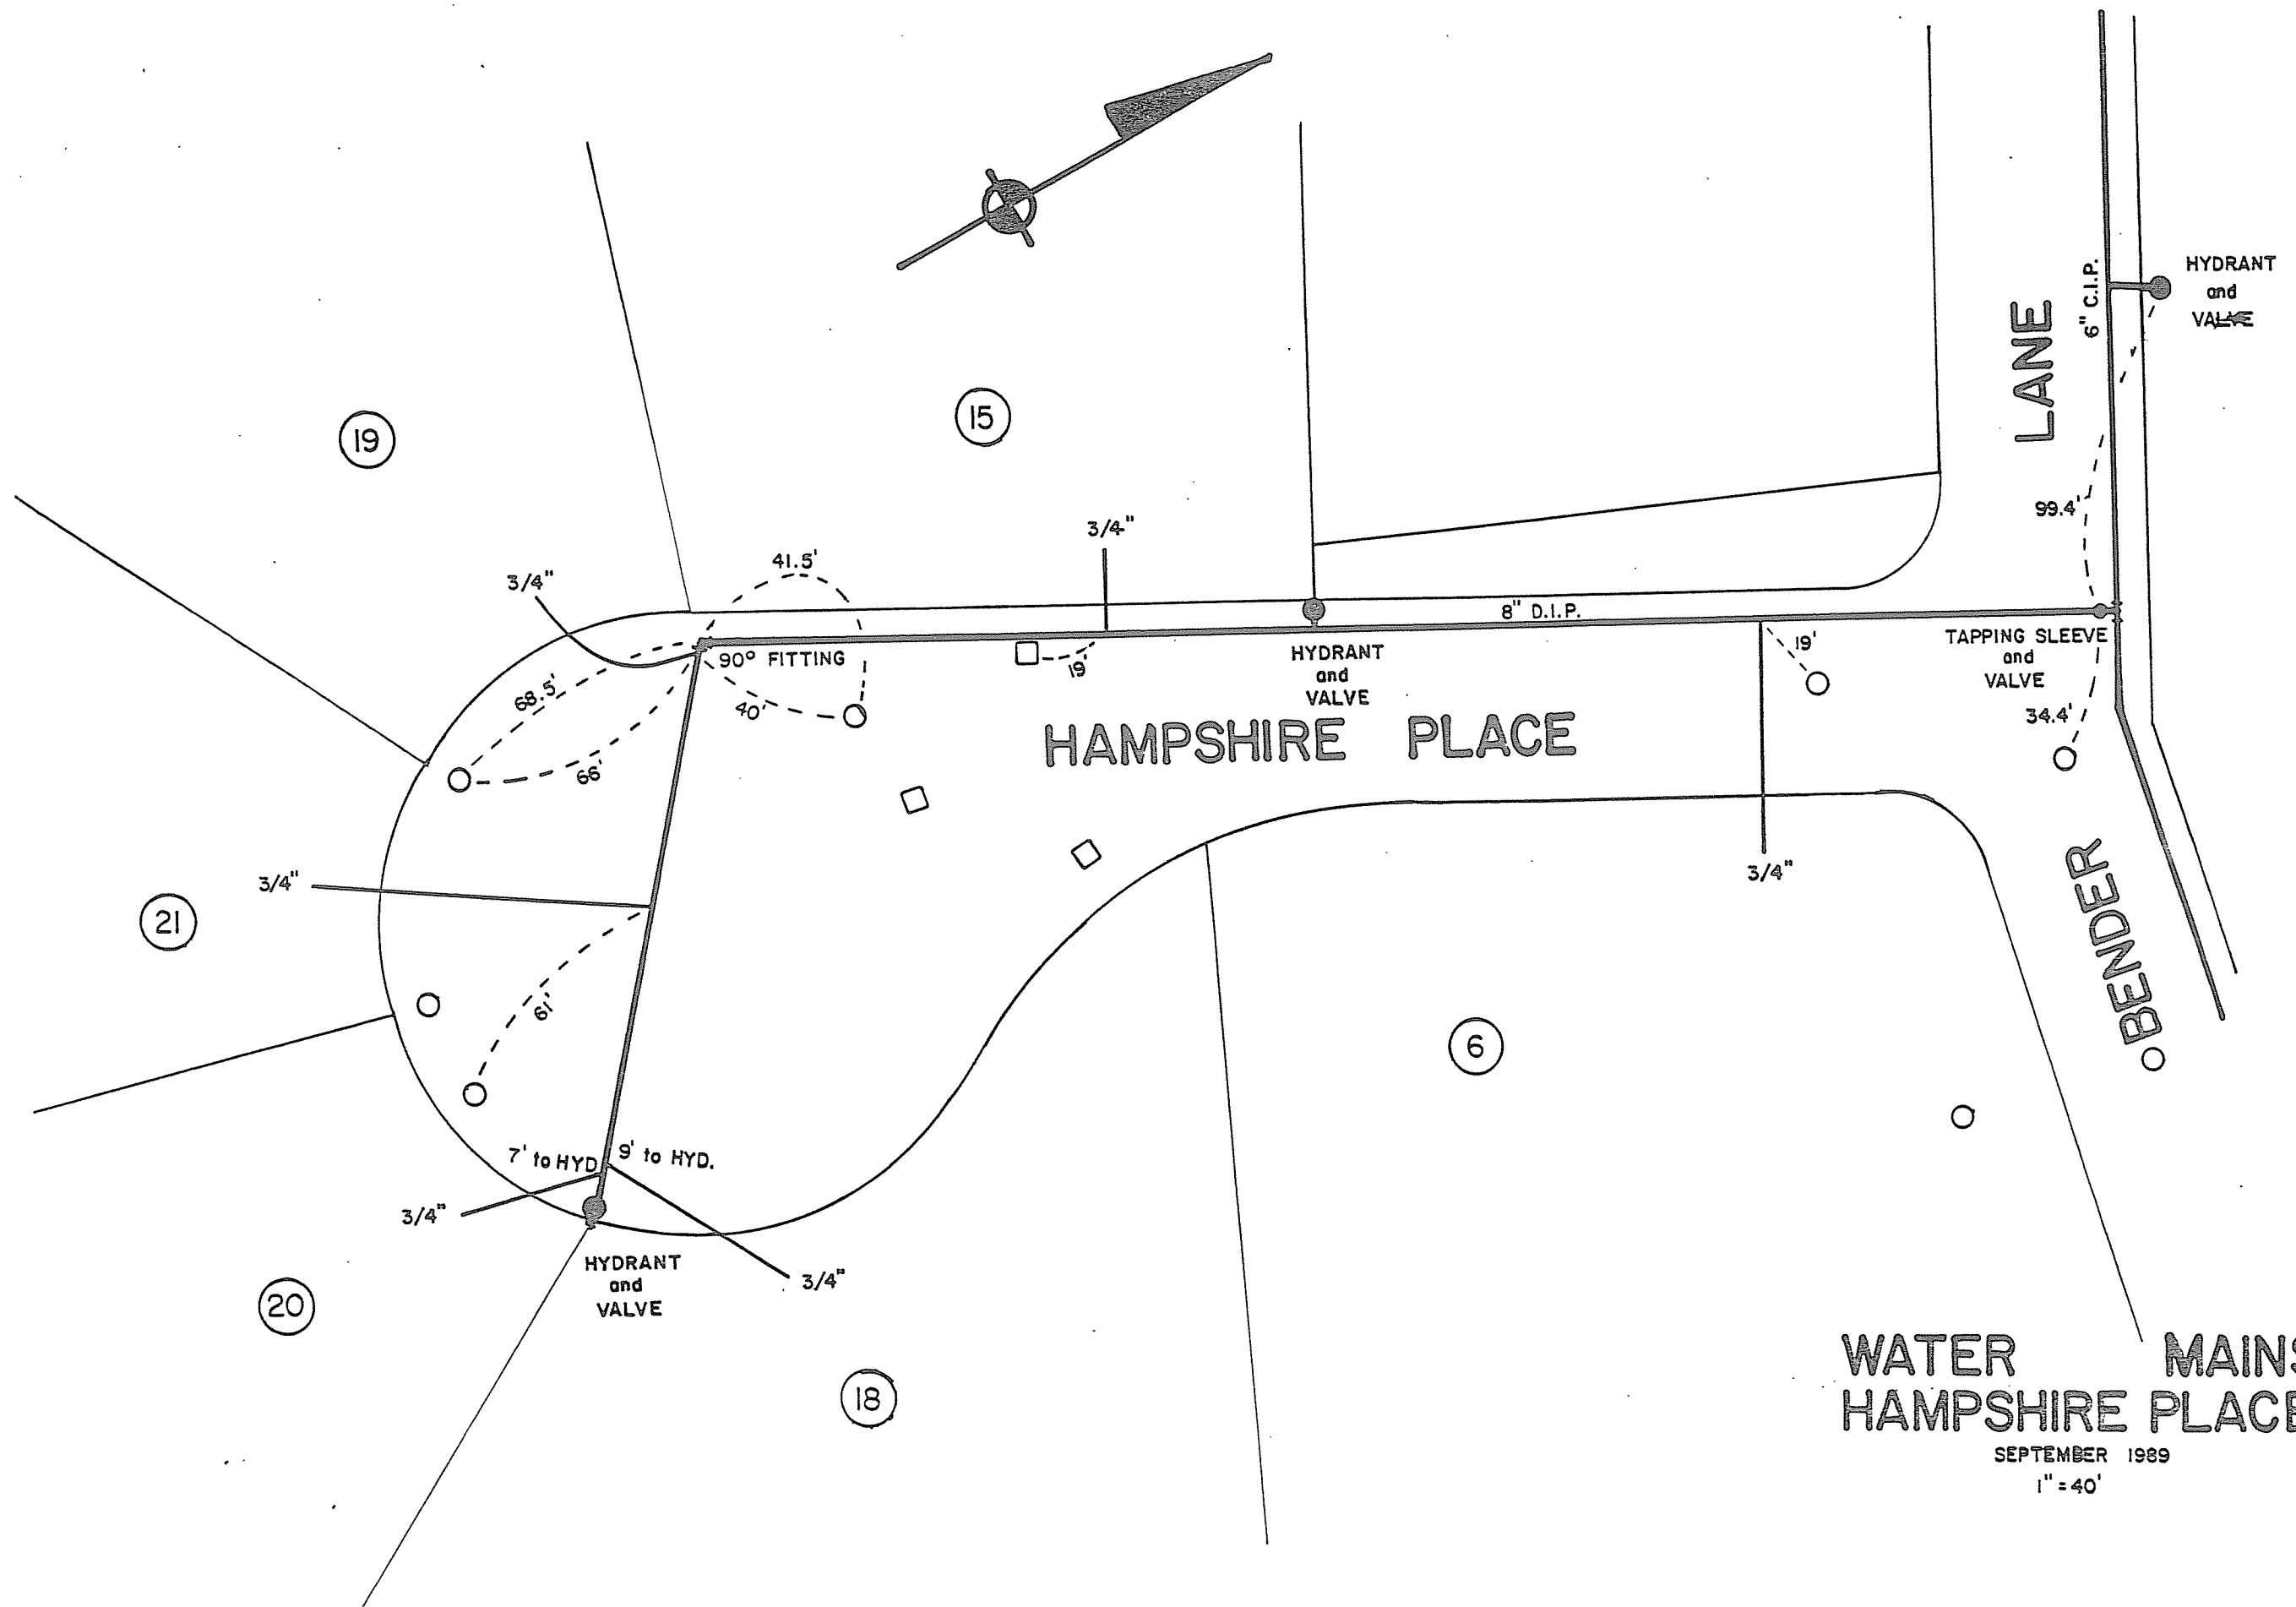

WATER MAINS
HAMPSHIRE PLACE

SEPTEMBER 1989

1" = 40'