


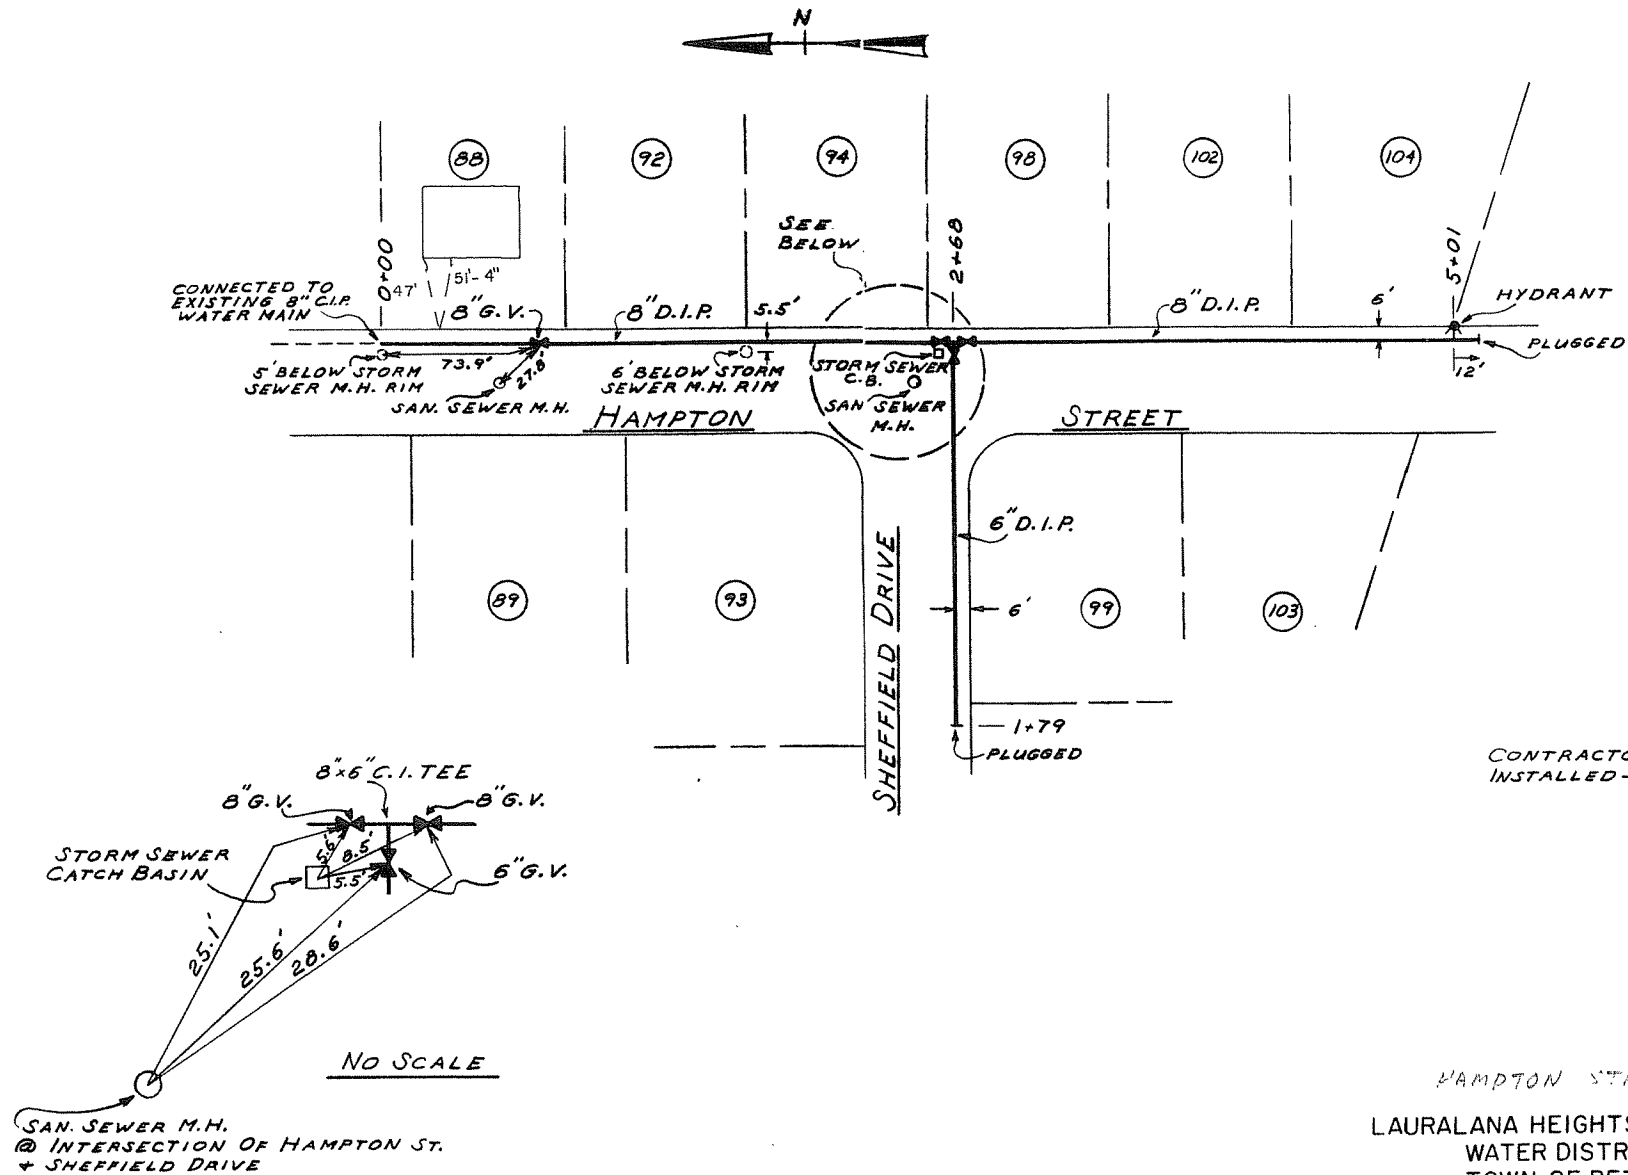

CONTRACTOR - DUBUQUE
INSTALLED - JANUARY 1974

HAMPTON STREET

LAURALANA HEIGHTS EXTENSION NO. 1
WATER DISTRICT NO. 1
TOWN OF BETHLEHEM
RECORD OF INSTALLATIONS
SCALE: 1" = 60' APRIL 1975
J. KENNETH FRASER & ASSOCIATES, P.C.
CONSULTING ENGRS. RENSSELAER, N.Y.