


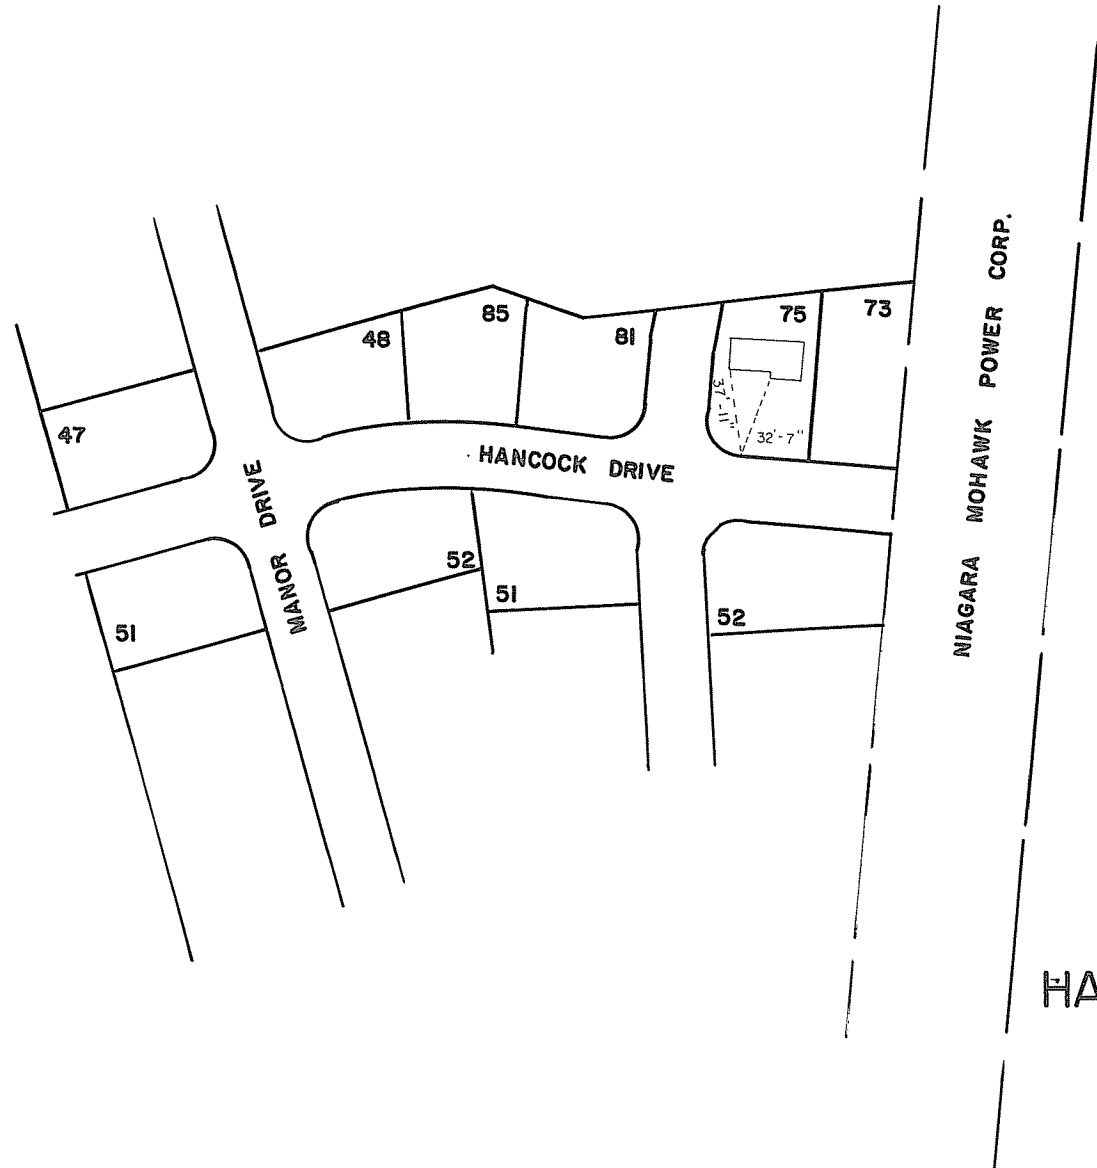

HANCOCK DRIVE