


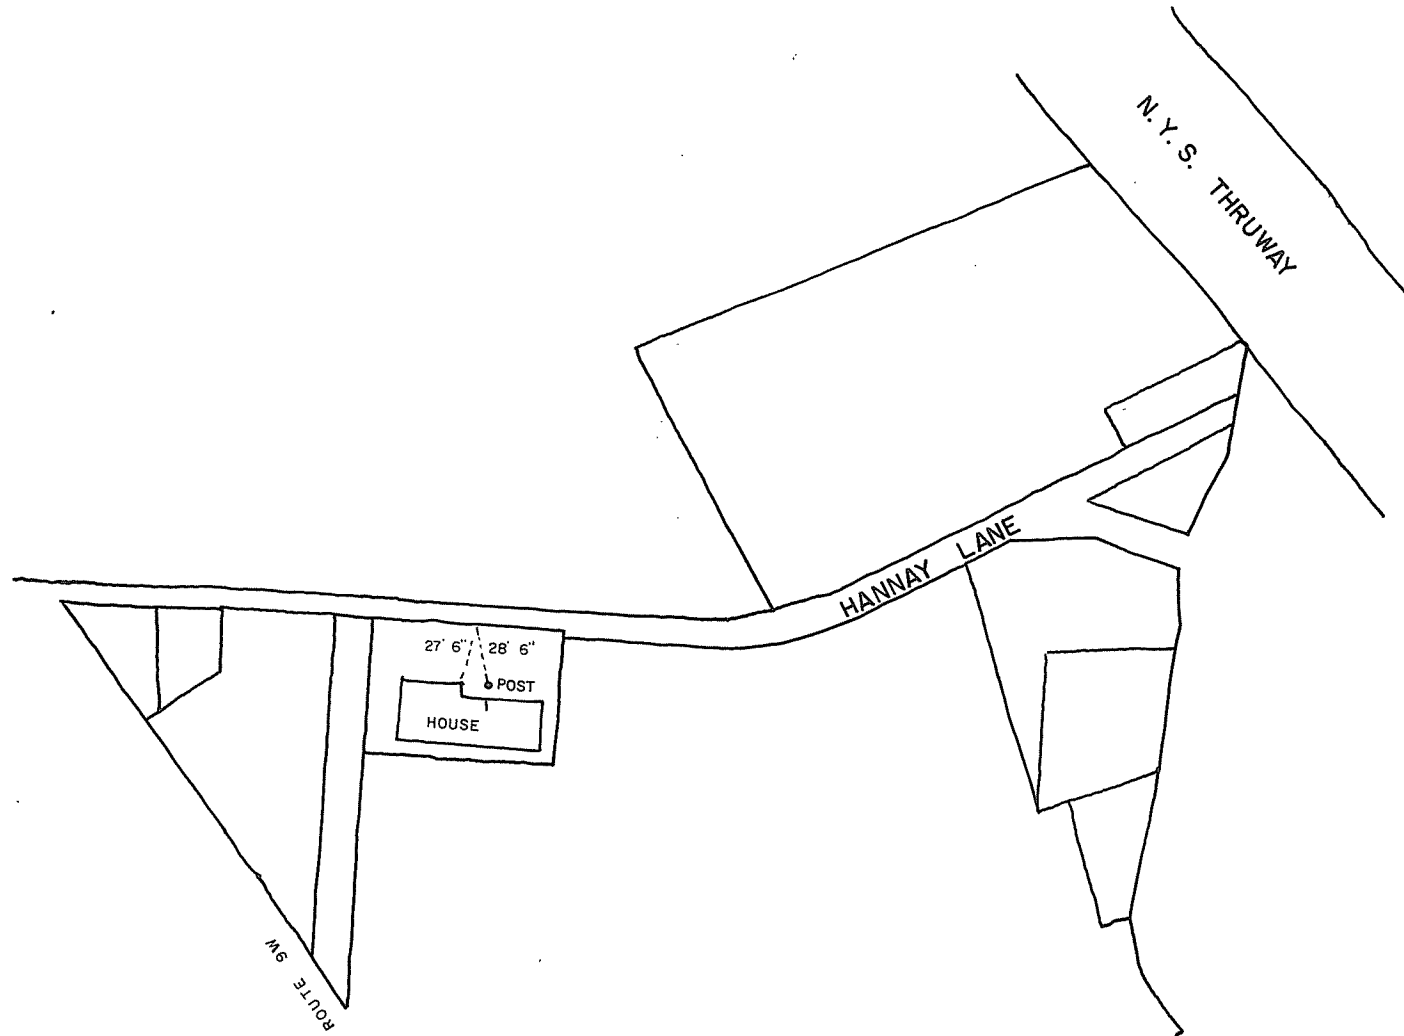

HANNAY LANE