


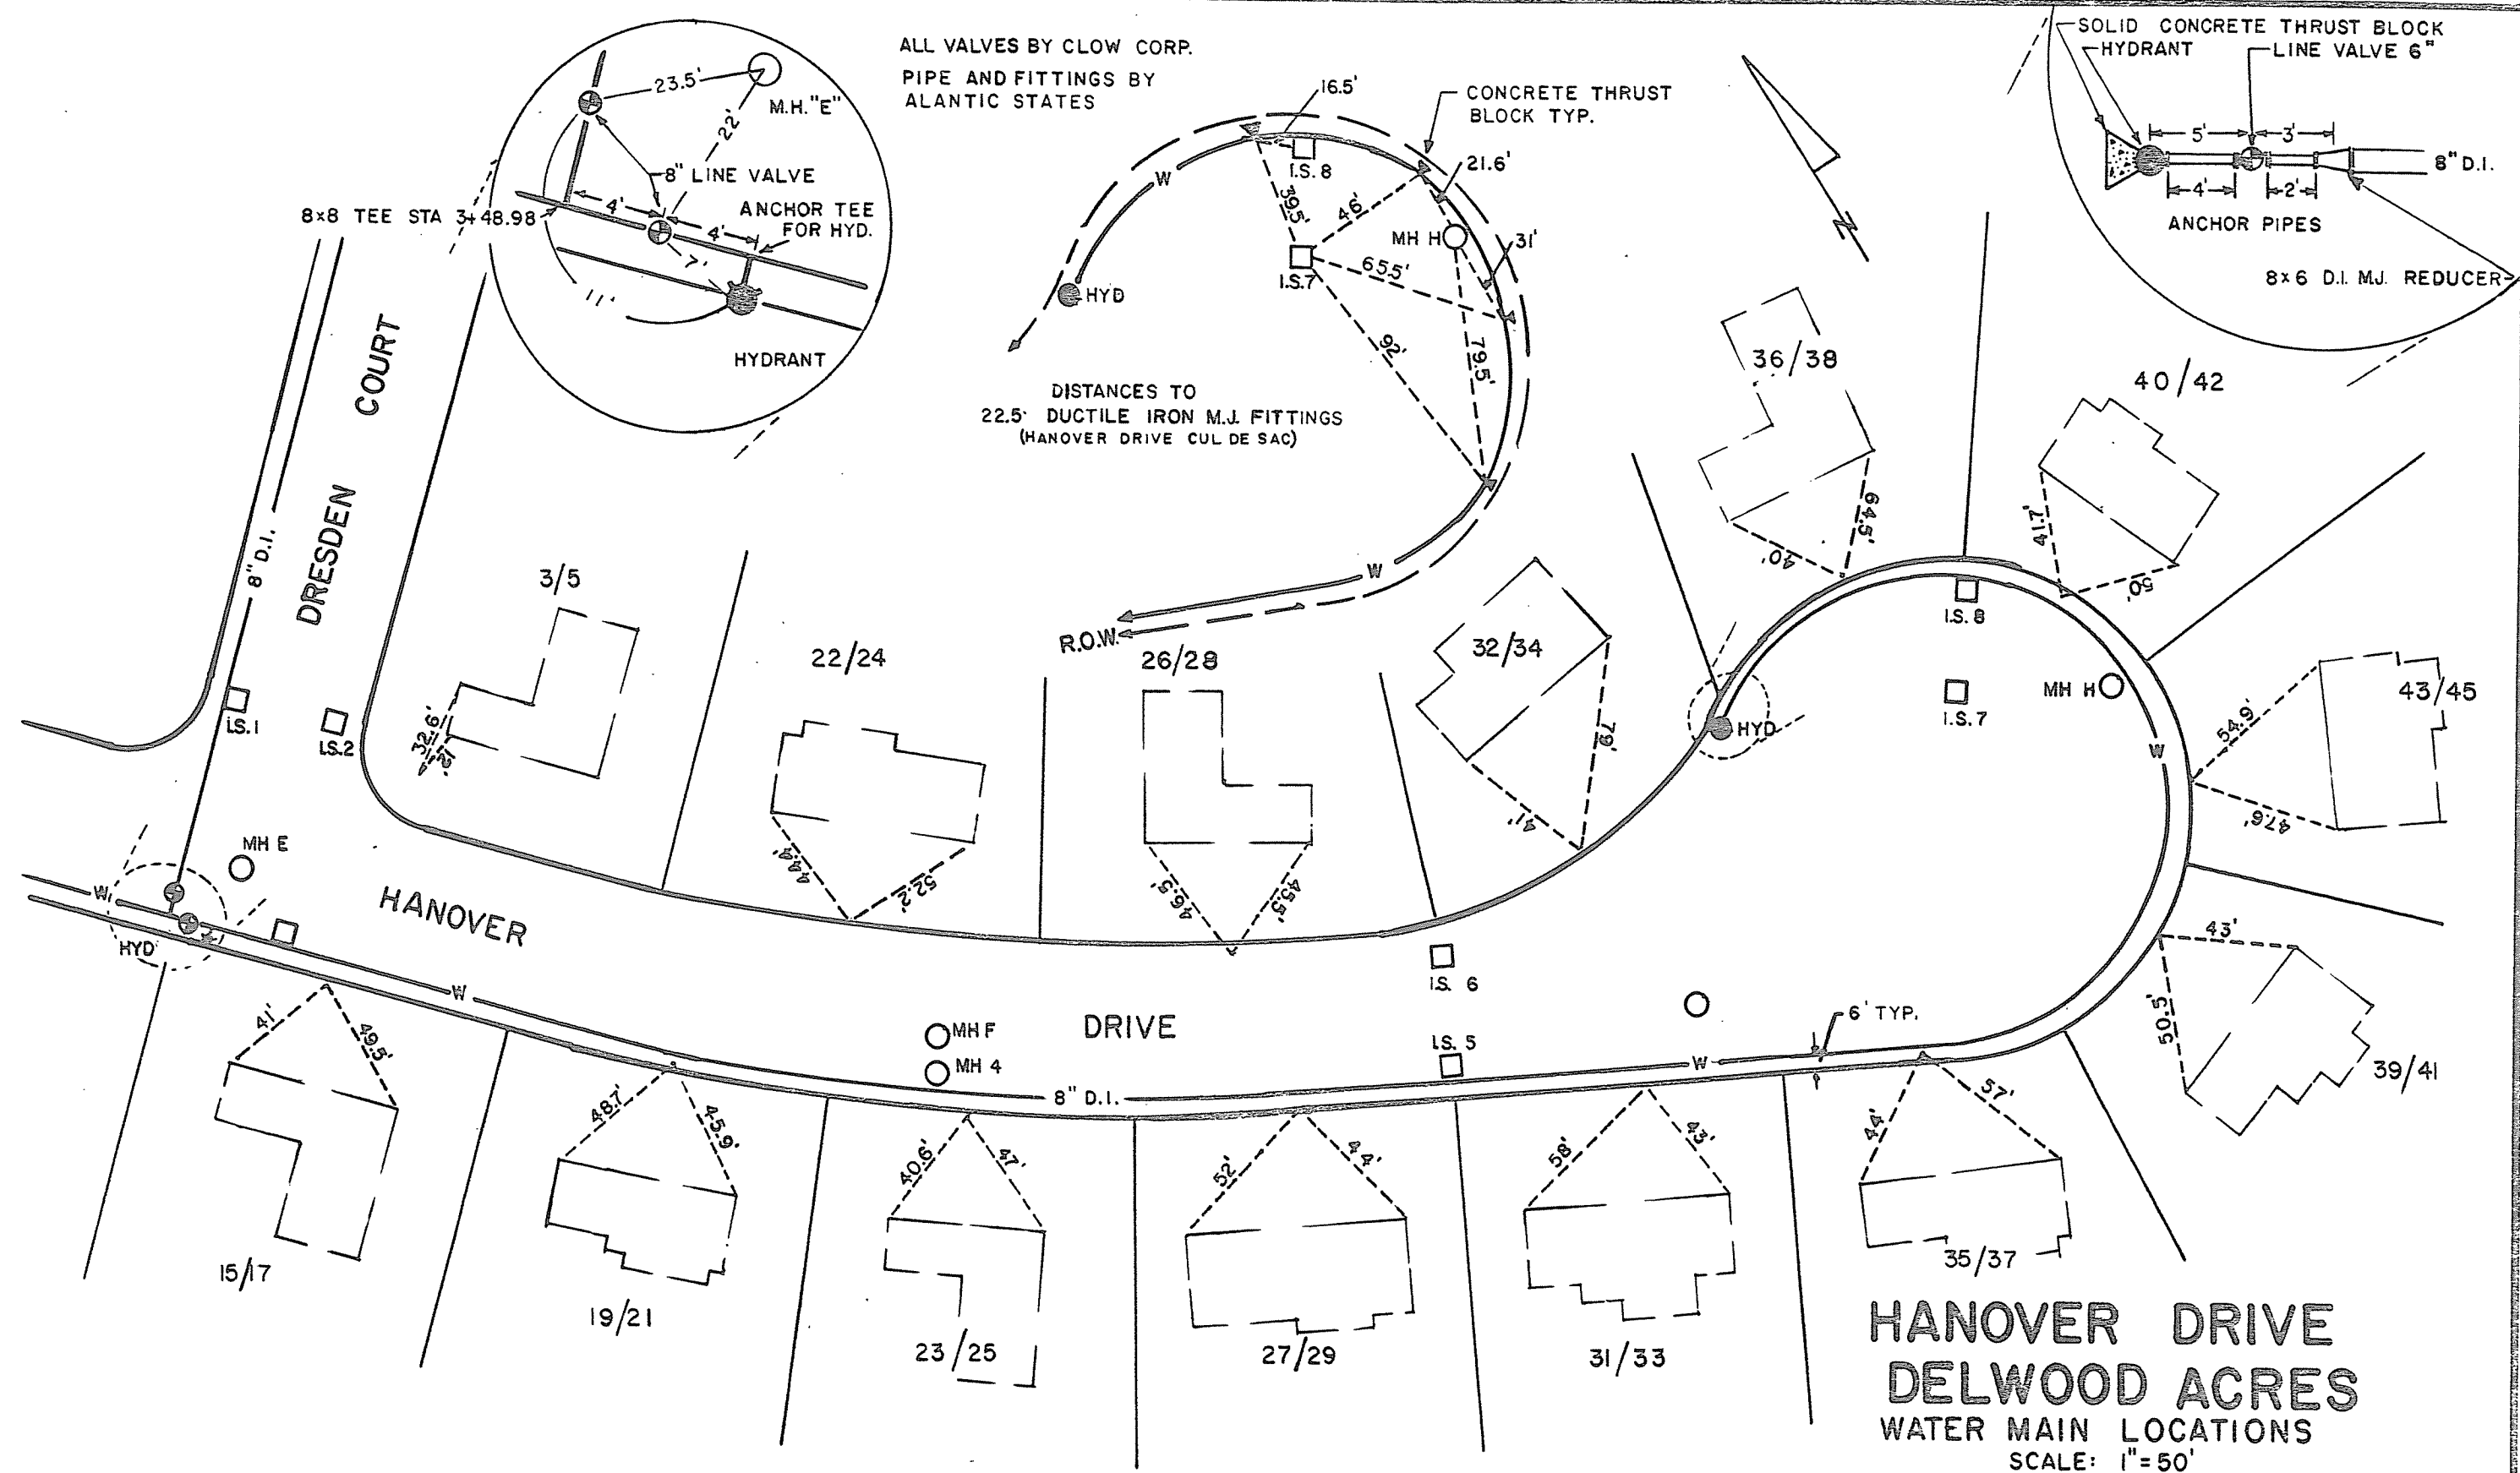

**HANOVER DRIVE
DELWOOD ACRES**
 WATER MAIN LOCATIONS
 SCALE: 1"=50'

DECEMBER, 1987
 DWN BY: KAN
 CHECKED BY: CW

CONSTRUCTED 9-10/87