


KENWOOD AVENUE

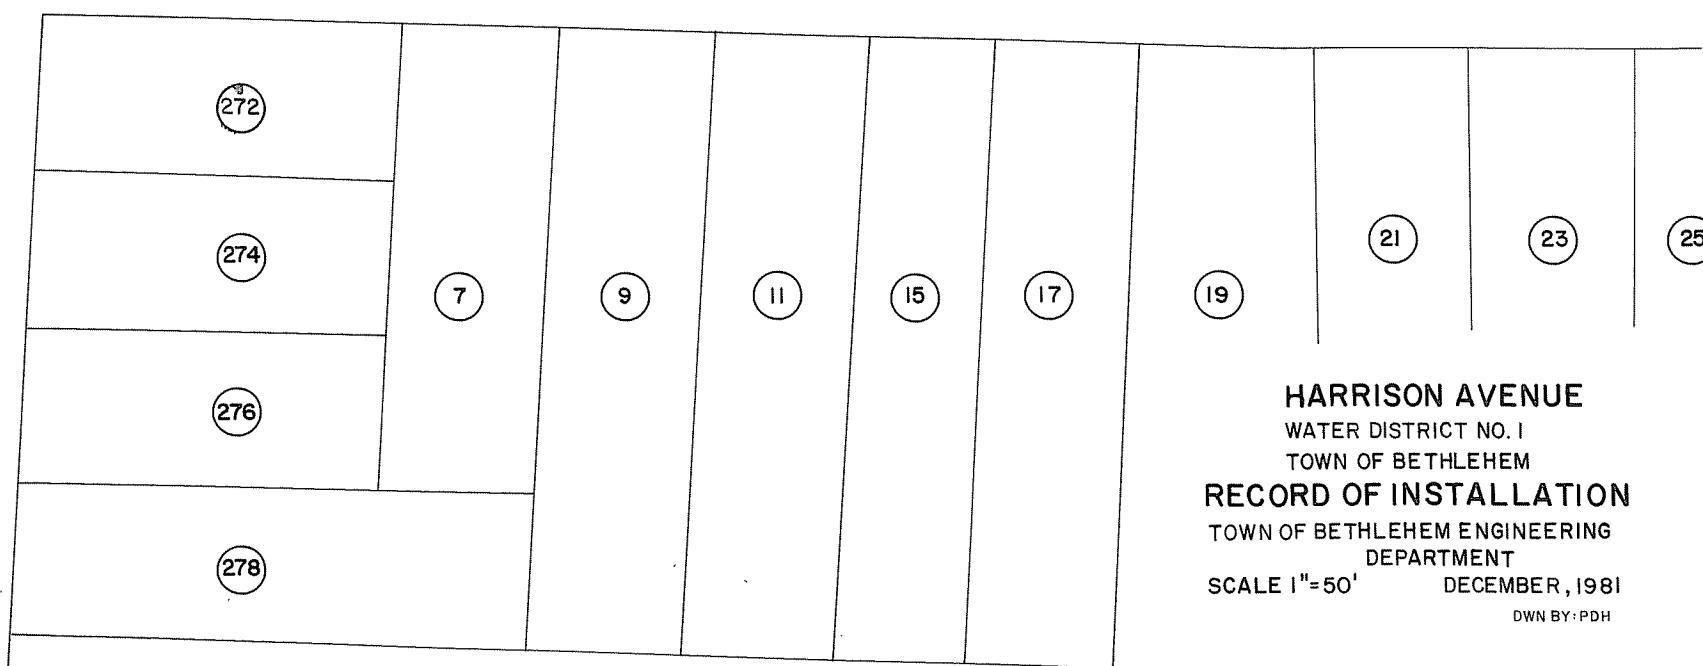

HARRISON AVENUE
WATER DISTRICT NO. I
TOWN OF BETHLEHEM
RECORD OF INSTALLATION
TOWN OF BETHLEHEM ENGINEERING
DEPARTMENT
SCALE 1"=50' DECEMBER, 1981
DWN BY: PDH