

HARRISON AVENUE

WATER DISTRICT NO. 1

TOWN OF BETHLEHEM

**RECORD OF INSTALLATION**


TOWN OF BETHLEHEM ENGINEERING

DEPARTMENT

SCALE 1"=50' DECEMBER, 1981

DWN BY: PDH

N

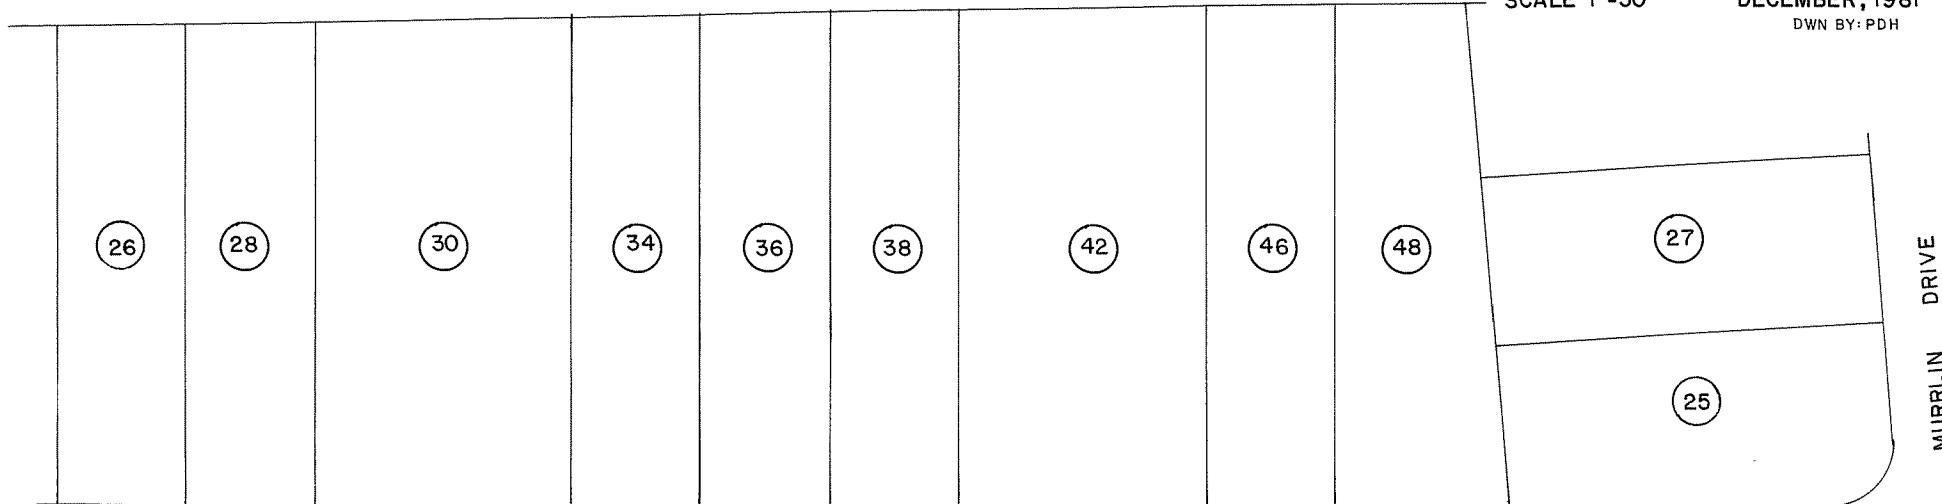

HARRISON

AVENUE

