


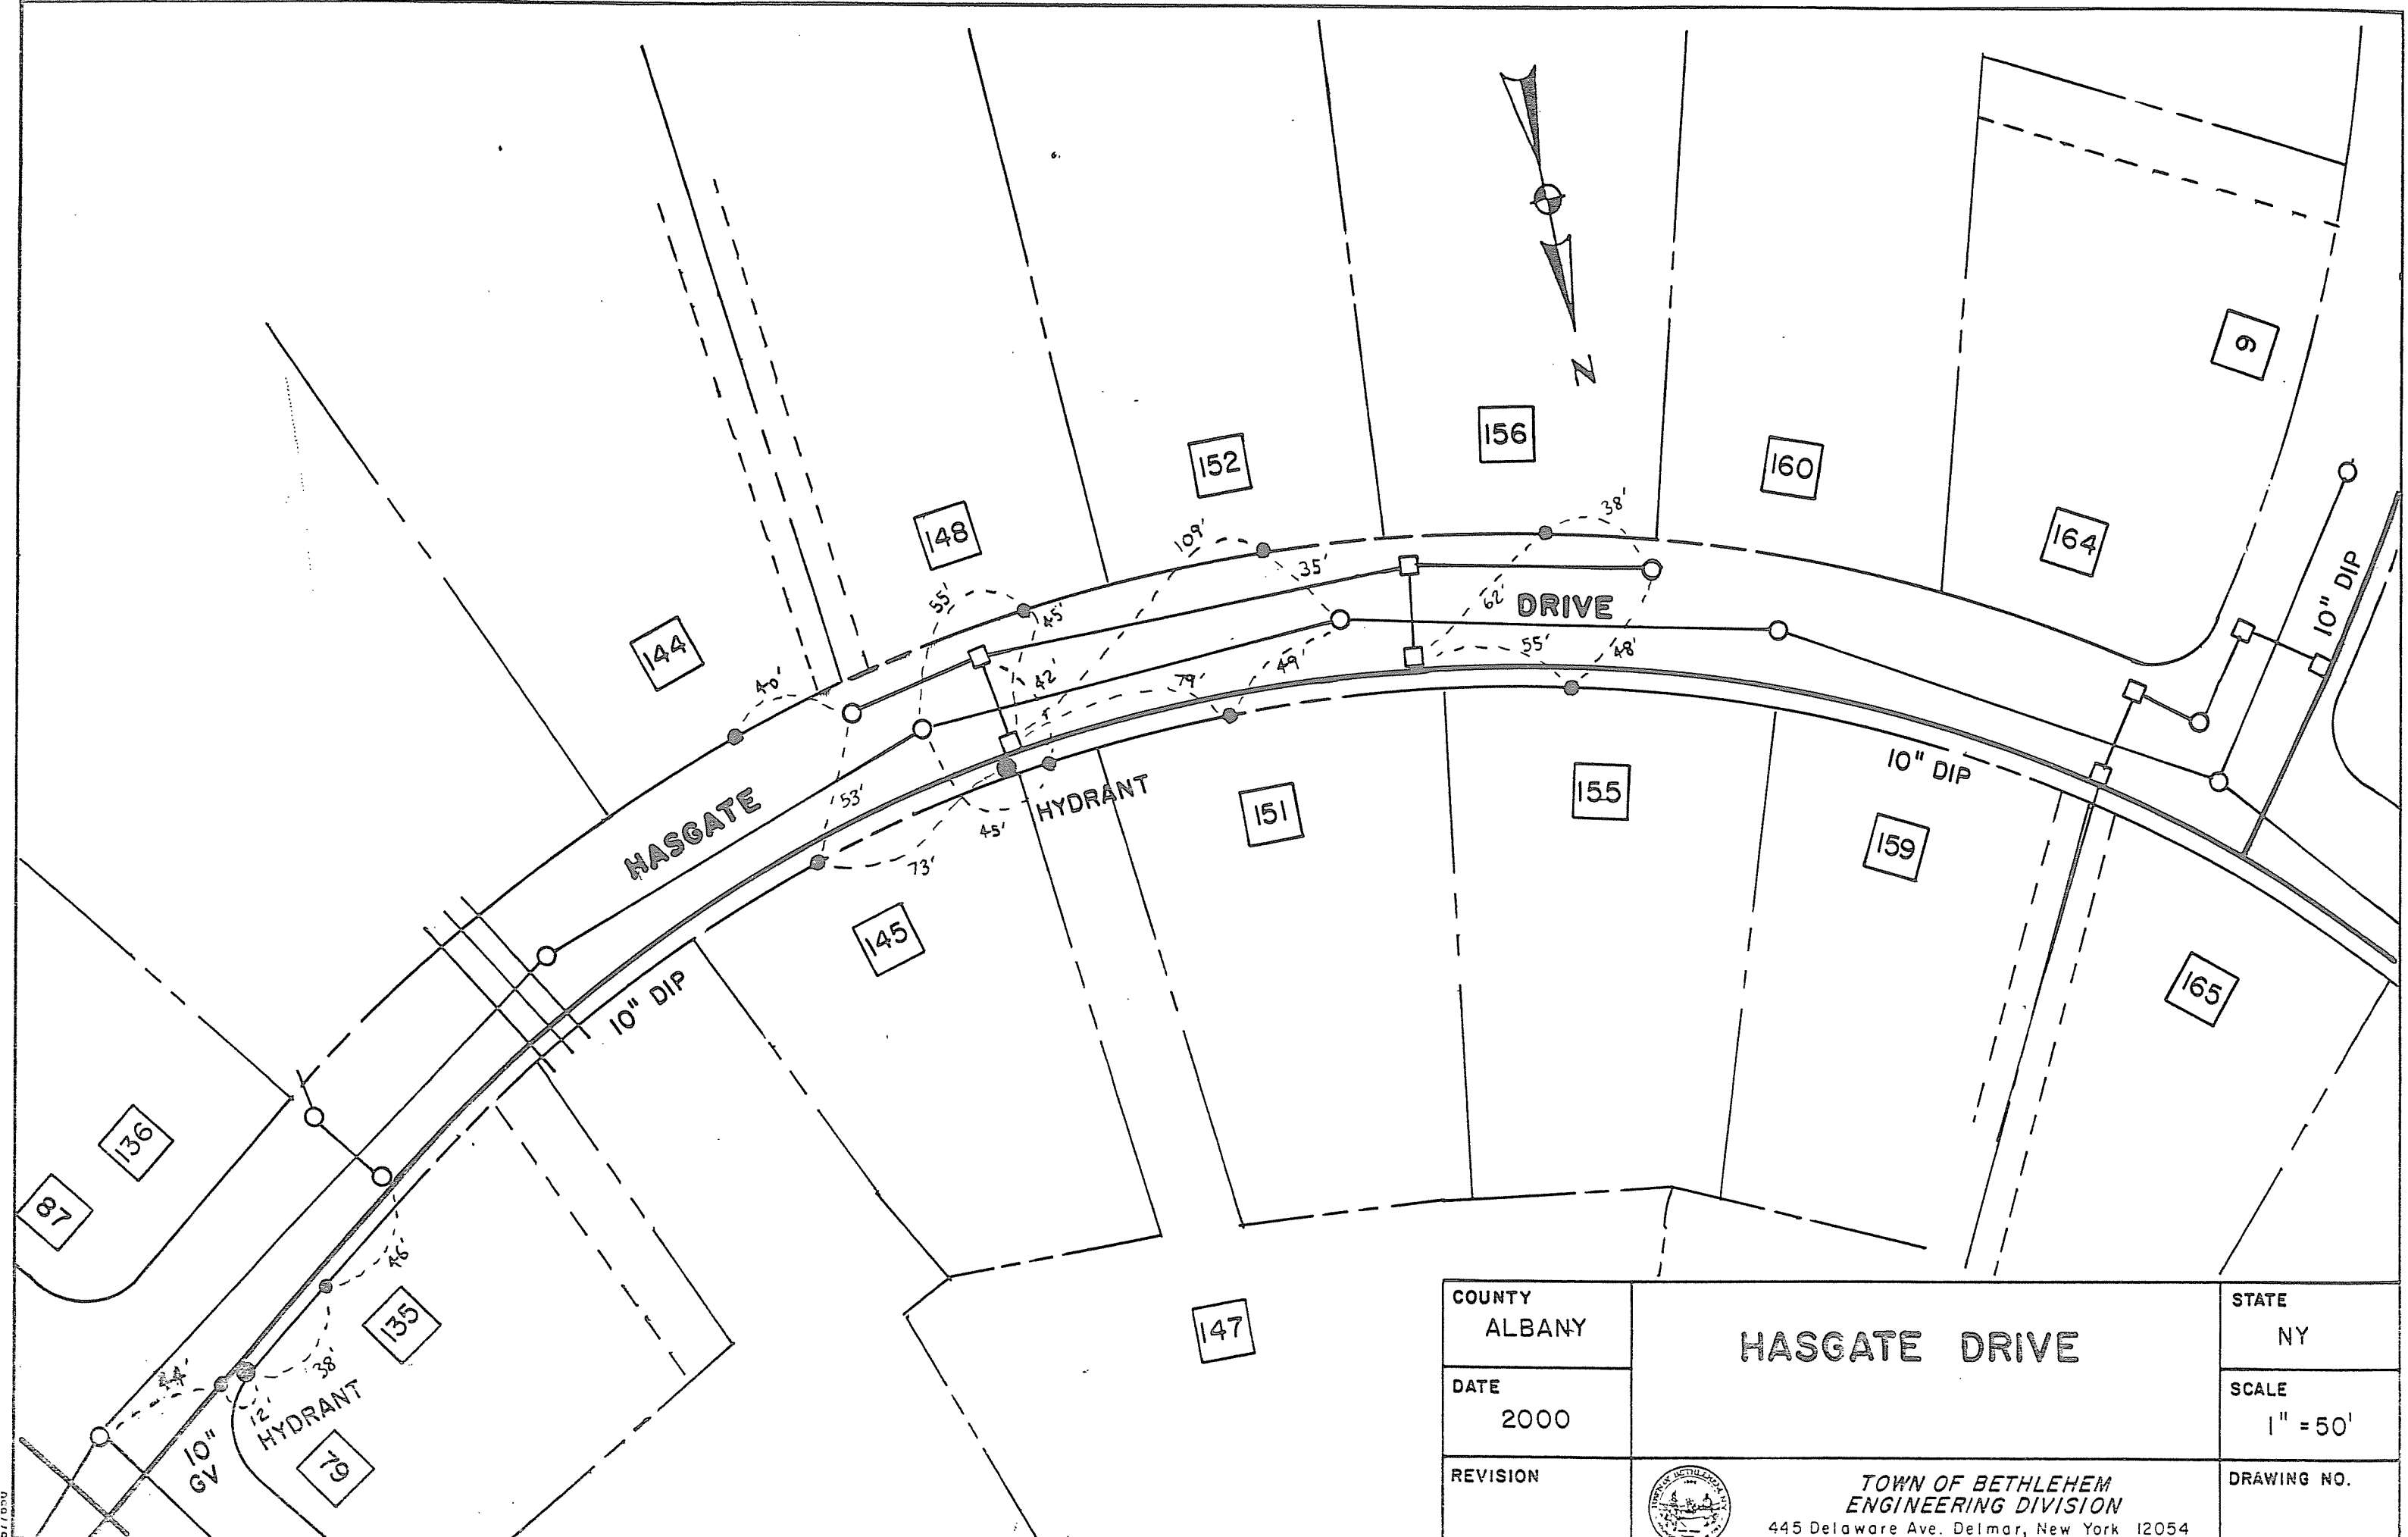

COUNTY ALBANY	HASGATE DRIVE	STATE NY
DATE 2000		SCALE 1" = 50'
REVISION	 TOWN OF BETHLEHEM ENGINEERING DIVISION 445 Delaware Ave. Delmar, New York 12054	DRAWING NO.

2/1/03