


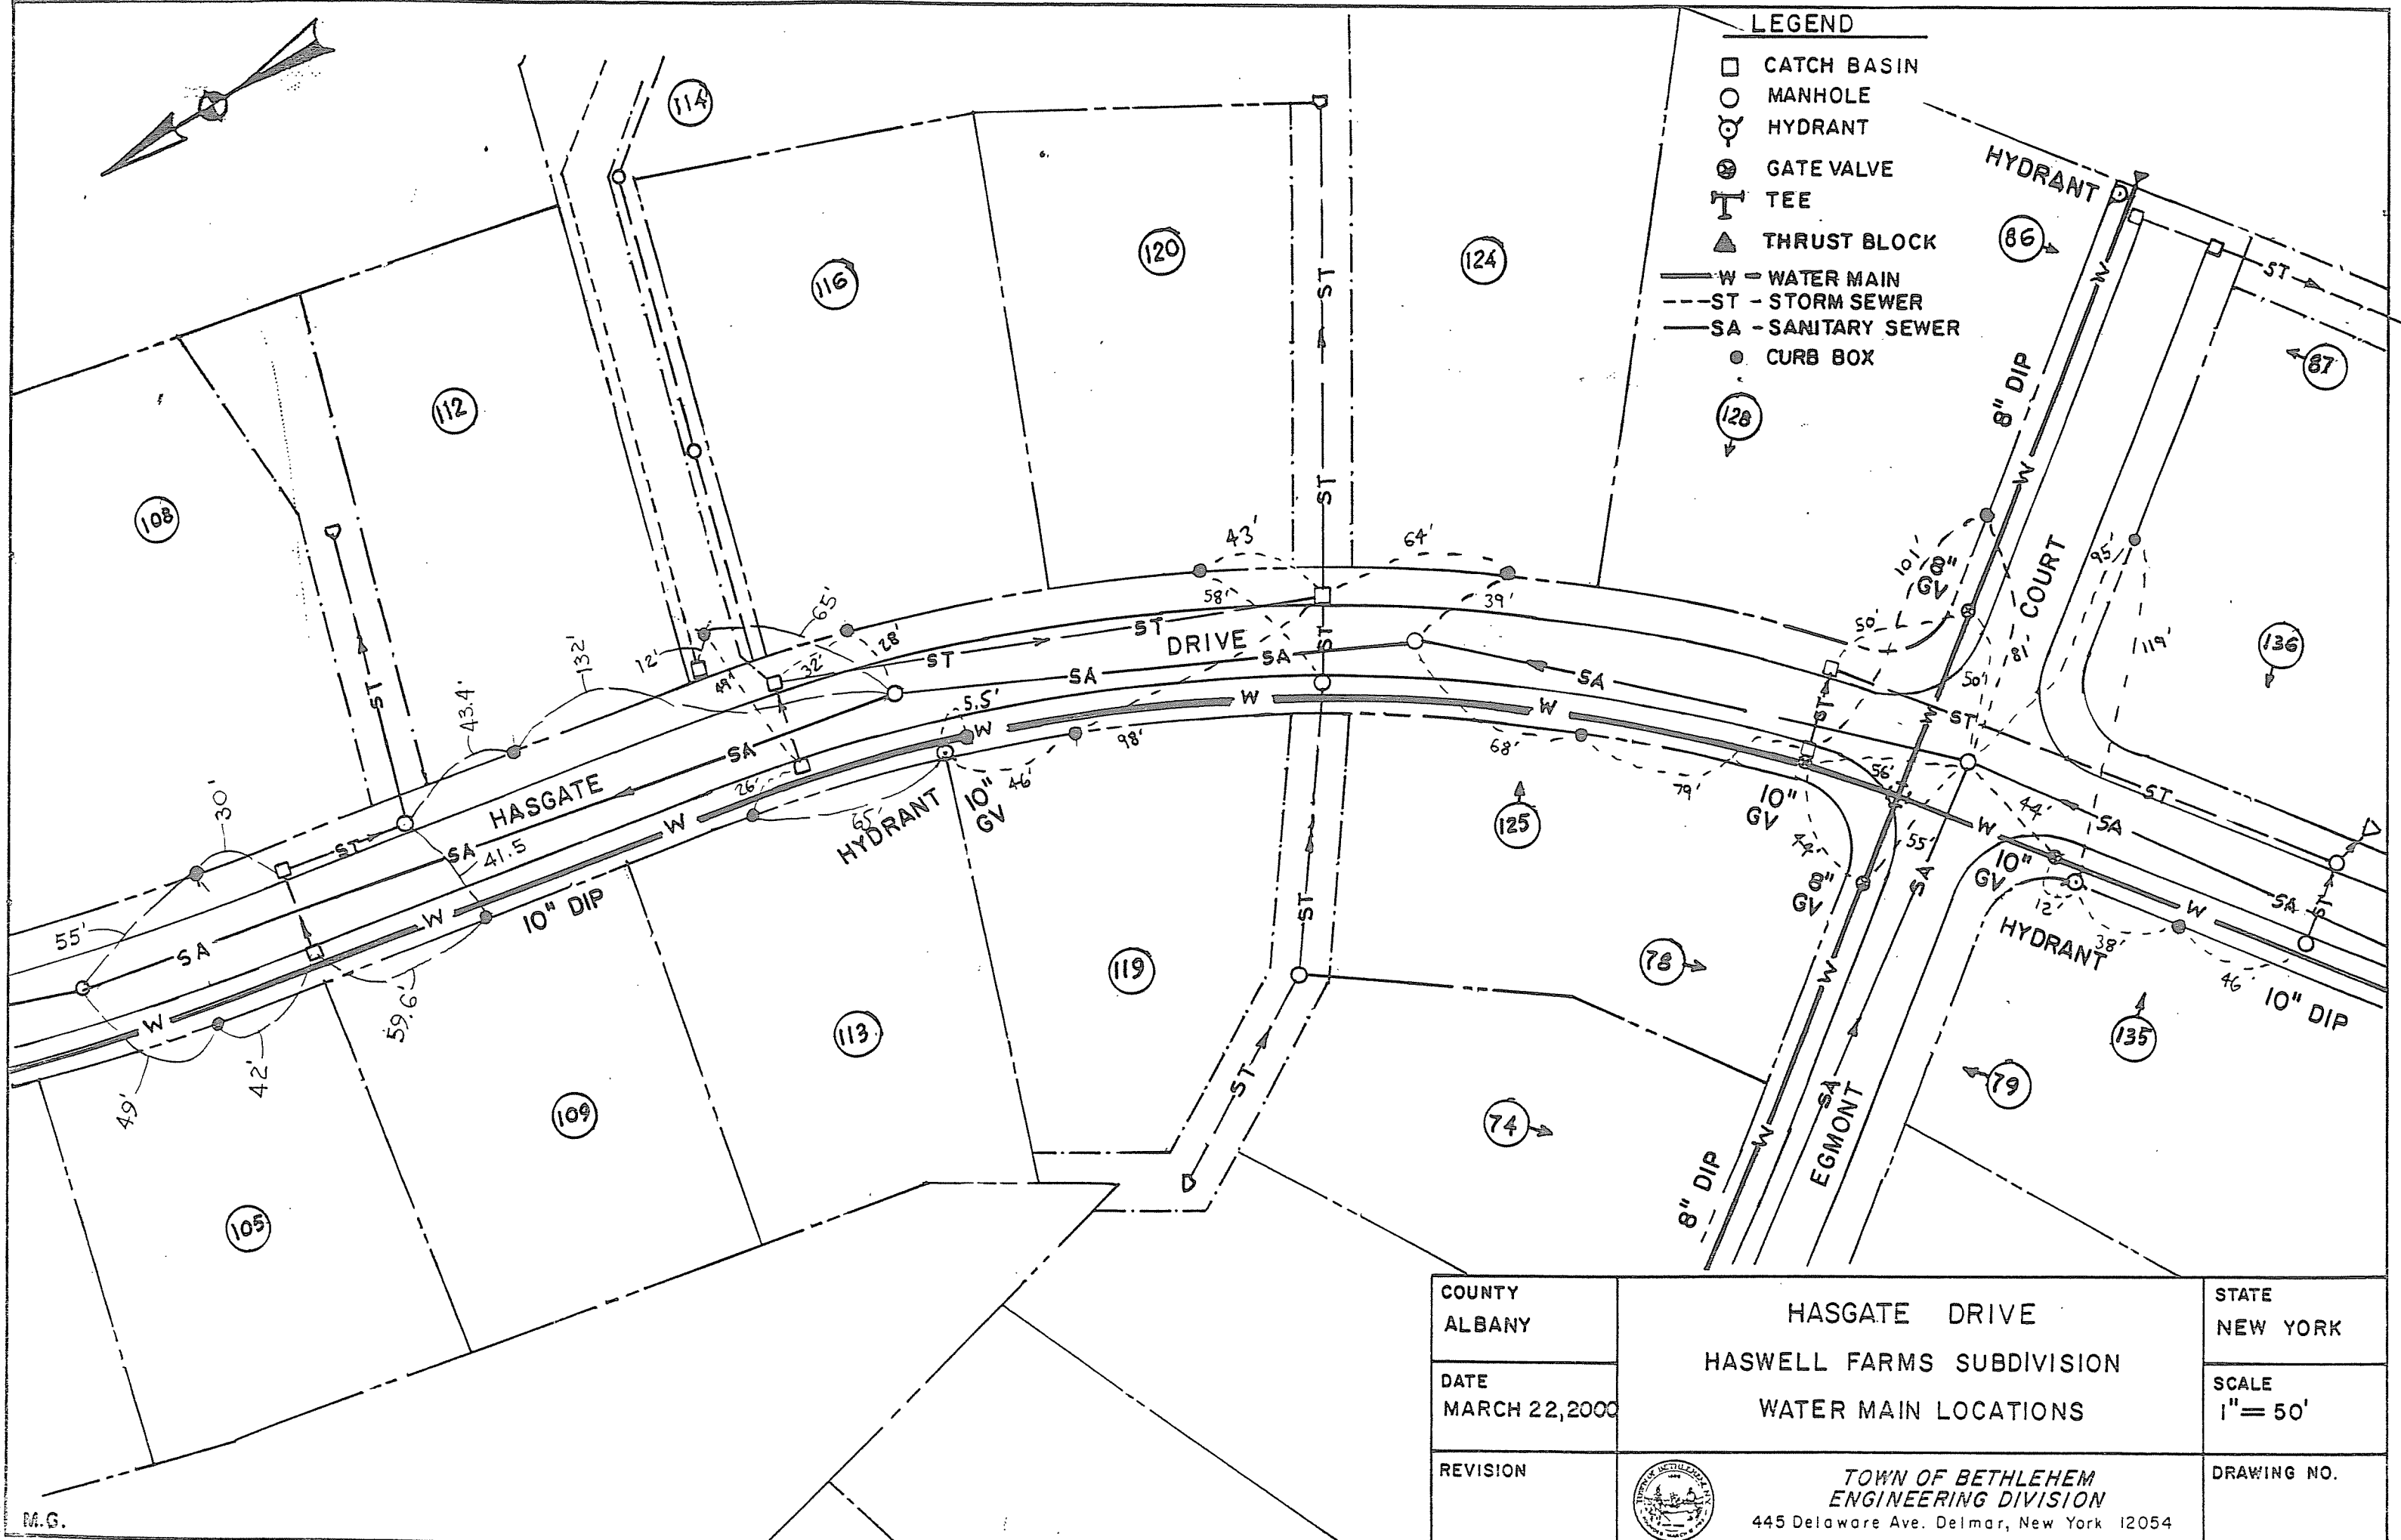

COUNTY	ALBANY
DATE	MARCH 22, 2000
REVISION	

HASGATE DRIVE
HASWELL FARMS SUBDIVISION
WATER MAIN LOCATIONS
 TOWN OF BETHLEHEM ENGINEERING DIVISION 445 Delaware Ave. Delmar, New York 12054

STATE	NEW YORK
SCALE	1" = 50'
DRAWING NO.	

M.G.