


RUXTON

ROAD

# HASWELL GREENE

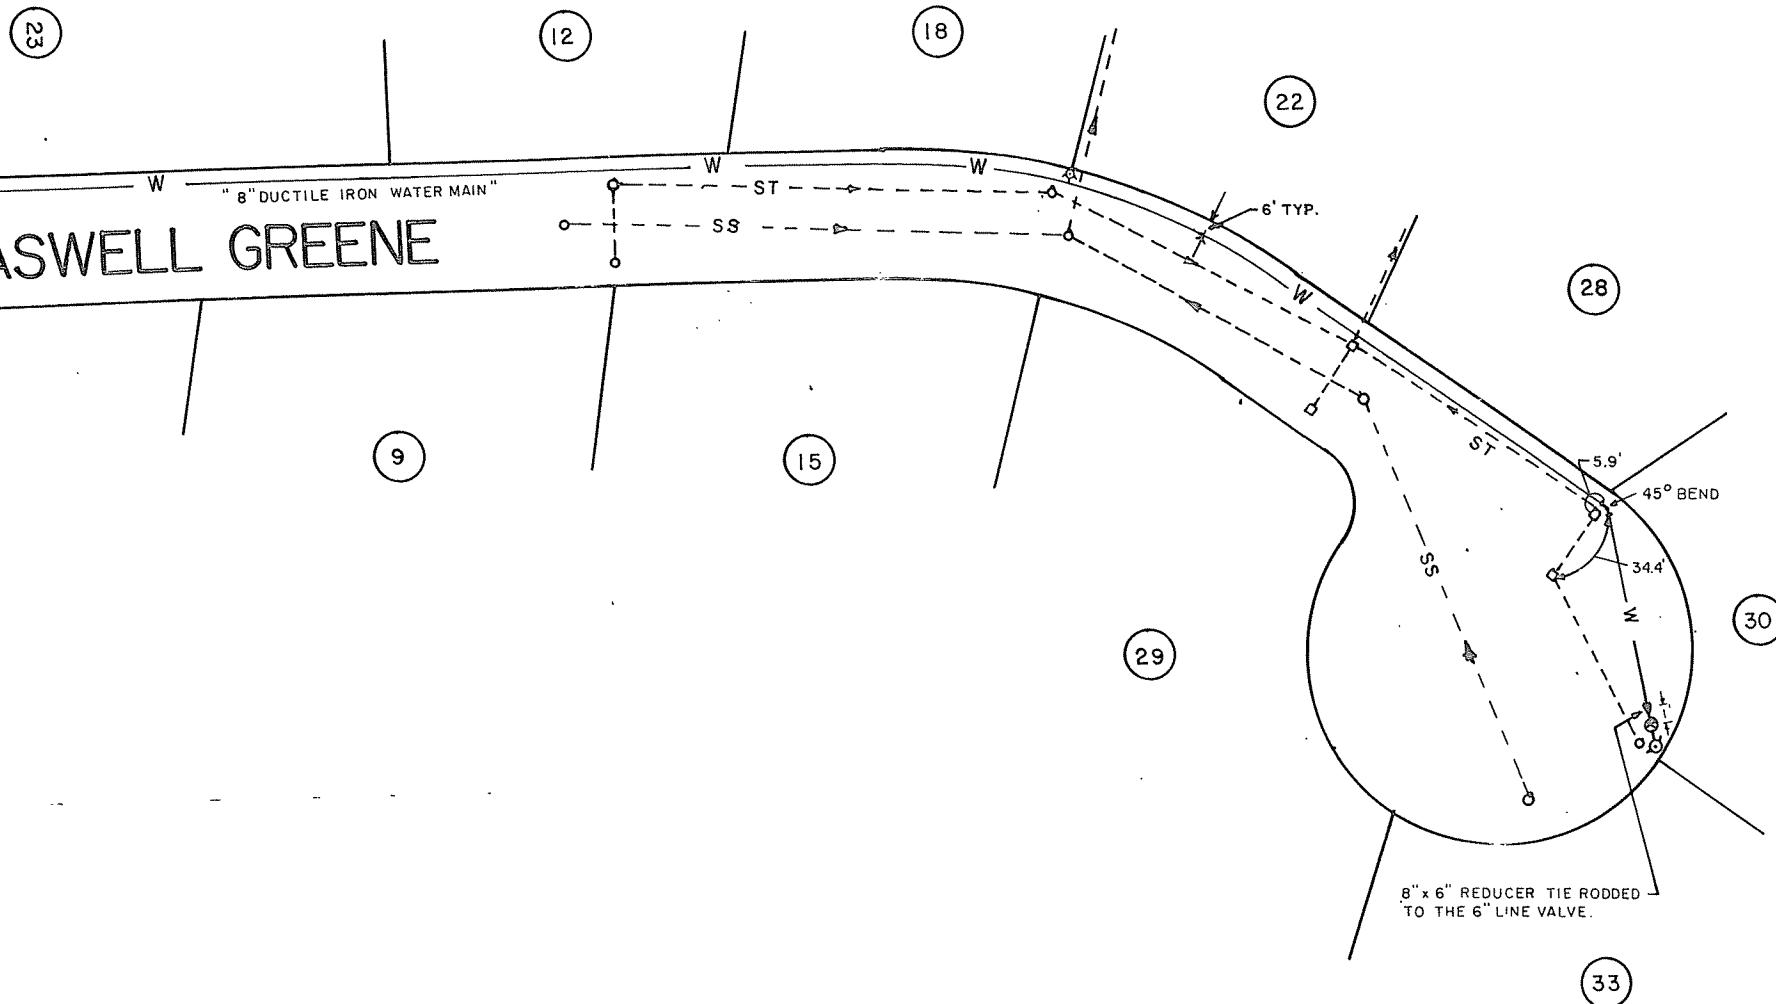

# HASWELL GREENE

WATER MAIN RECORD DRAWING  
KING JAMES GRANT SECTION 2,  
KNOWN AS "BRIARHILL"  
INSTALLED - MARCH 1986 by TRINITY CONST.  
SCALE 1" = 50'