

HAWTHORNE AVENUE

WATER DISTRICT NO. I

TOWN OF BETHLEHEM


RECORD OF INSTALLATION

TOWN OF BETHLEHEM ENGINEERING

DEPARTMENT

SCALE: 1"=50' JANUARY, 1982

DWN. BY: PDH

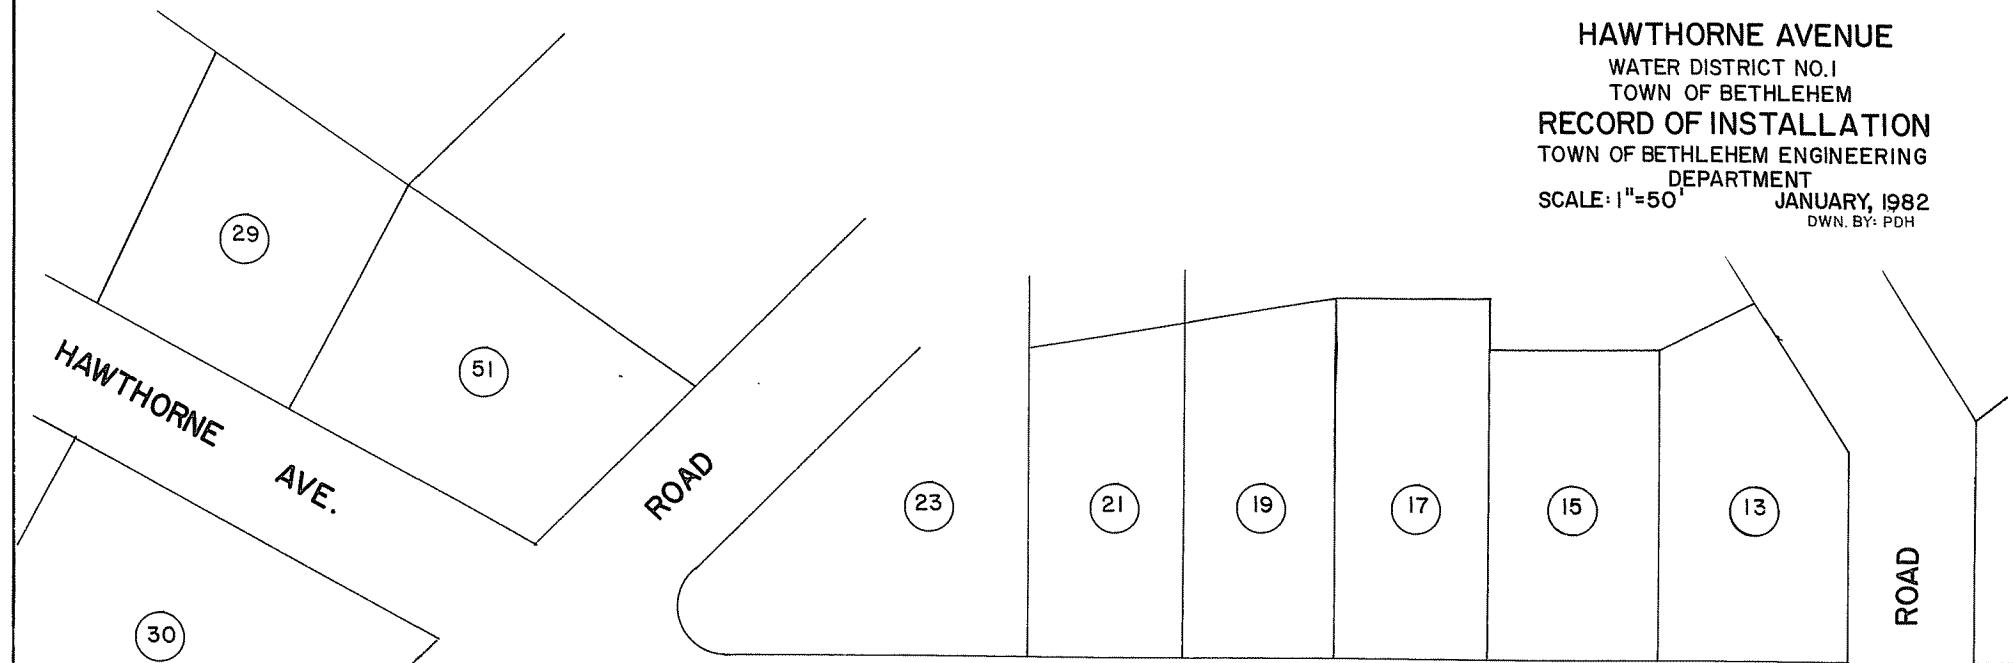

HAWTHORNE

AVENUE

WINNE

DOUGLAS ROAD

2

18

14

WELLINGTON