


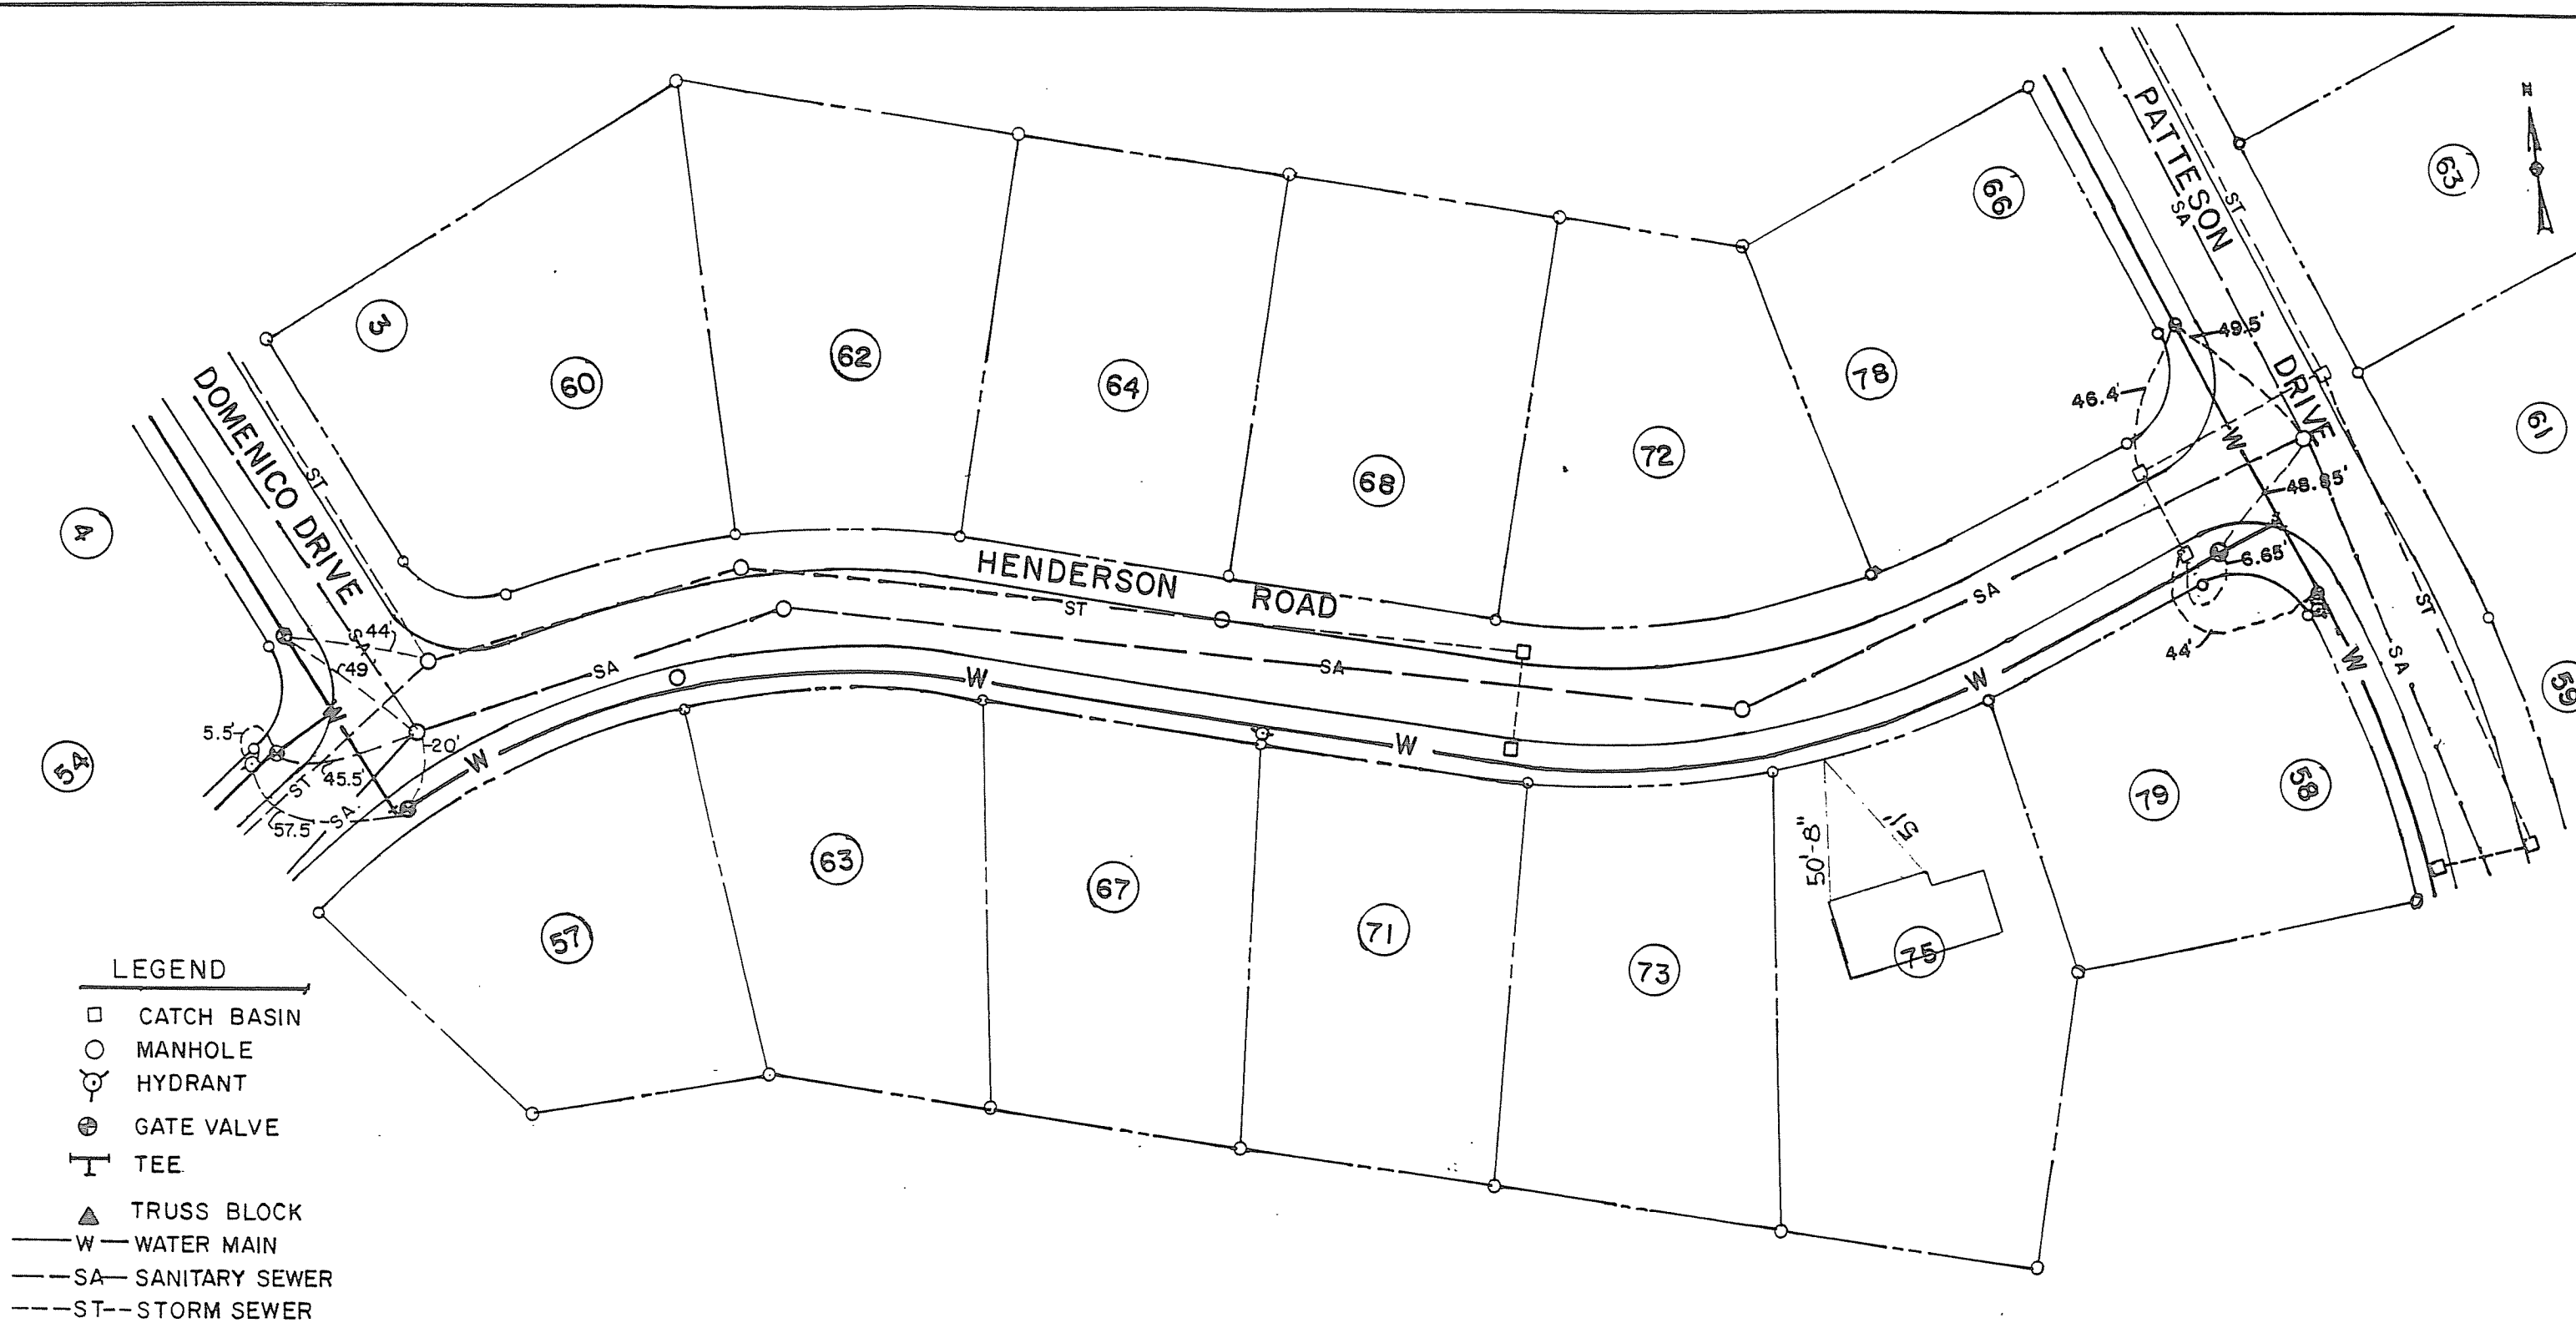

LEGEND

- CATCH BASIN
- MANHOLE
- ⊗ HYDRANT
- ⊕ GATE VALVE
- ⊥ TEE
- ▲ TRUSS BLOCK
- W— WATER MAIN
- SA— SANITARY SEWER
- ST--- STORM SEWER

NOTE:
ALL WATER MAINS SHALL BE 8" DUCTILE IRON.

COUNTY ALBANY	HENDERSON ROAD WATER MAIN	STATE NEW YORK
DATE OCT. 28, 1994		SCALE 1" = 50'
REVISION	 TOWN OF BETHLEHEM ENGINEERING DIVISION 445 Delaware Ave. Delmar, New York 12054	DRAWING NO.