


ROAD

BUSH

FEURA

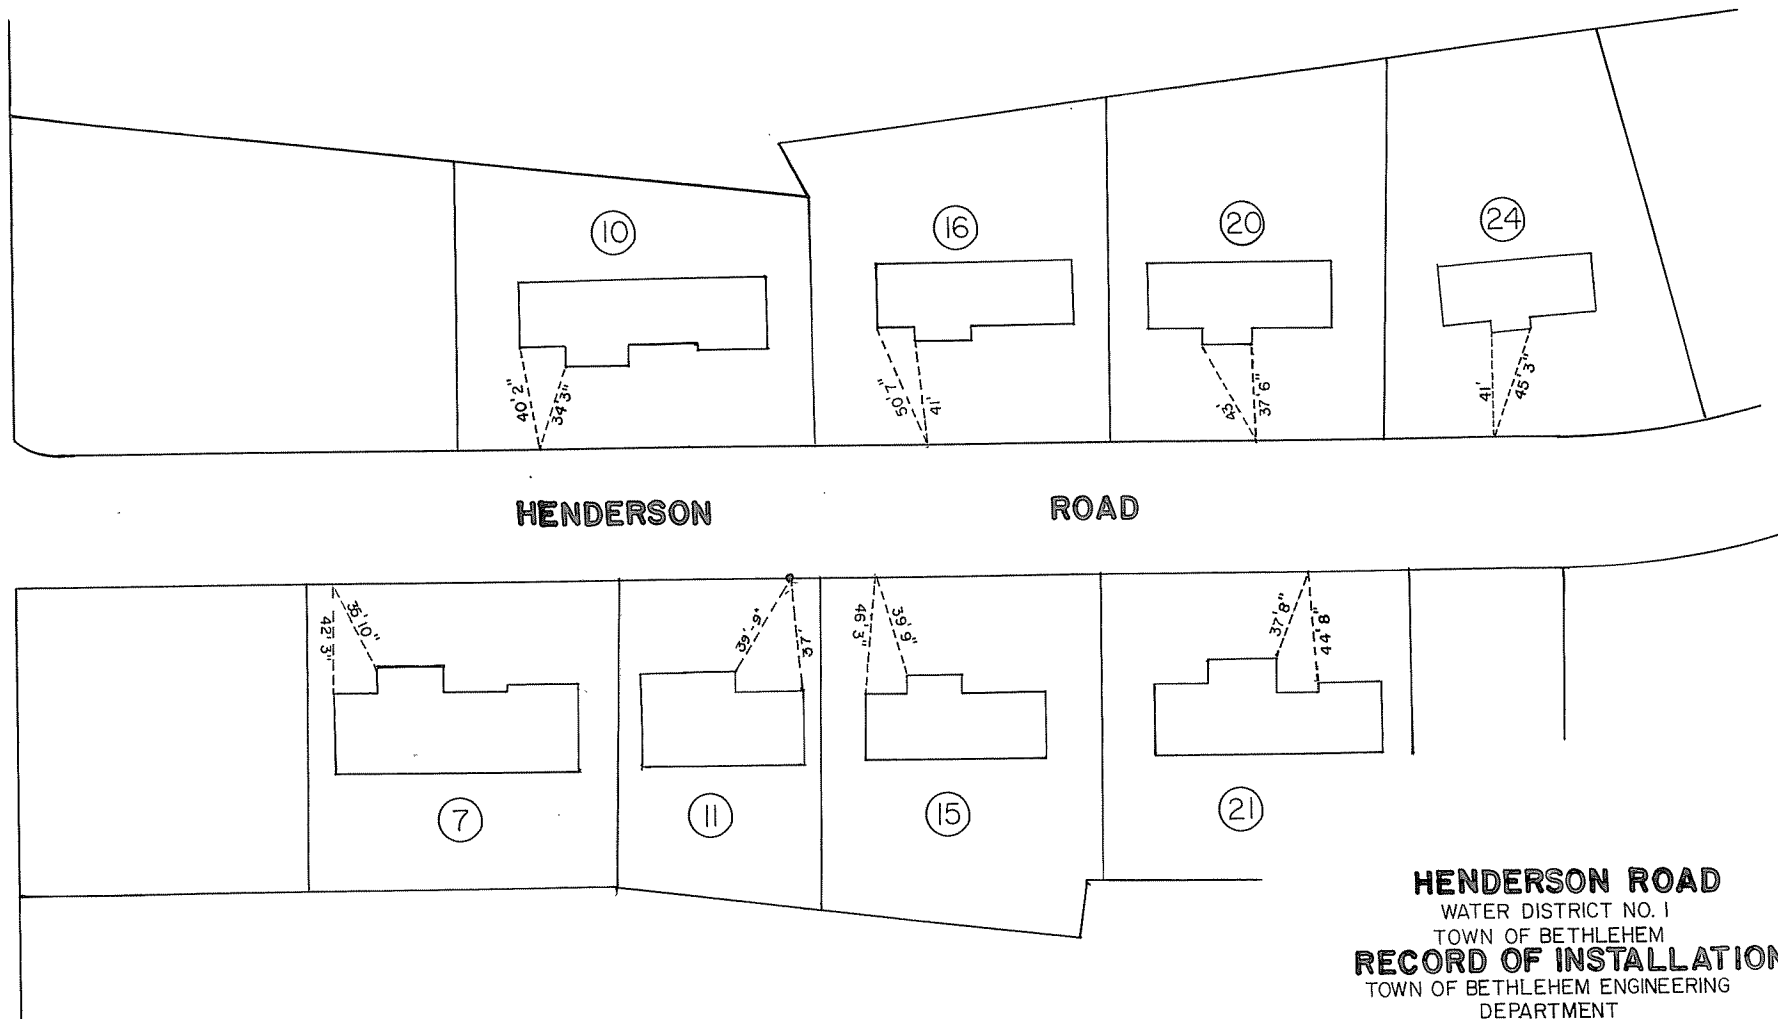

HENDERSON ROAD
WATER DISTRICT NO. 1
TOWN OF BETHLEHEM
RECORD OF INSTALLATION
TOWN OF BETHLEHEM ENGINEERING
DEPARTMENT

SCALE: 1" = 50'

JULY, 1986

DWN. BY M.D.P.