


HERBER AVENUE
WATER DISTRICT NO.1
TOWN OF BETHLEHEM
RECORD OF INSTALLATION
TOWN OF BETHLEHEM ENGINEERING
DEPARTMENT
SCALE: 1"=50' FEBRUARY, 1982
DWN. BY: PDH

N

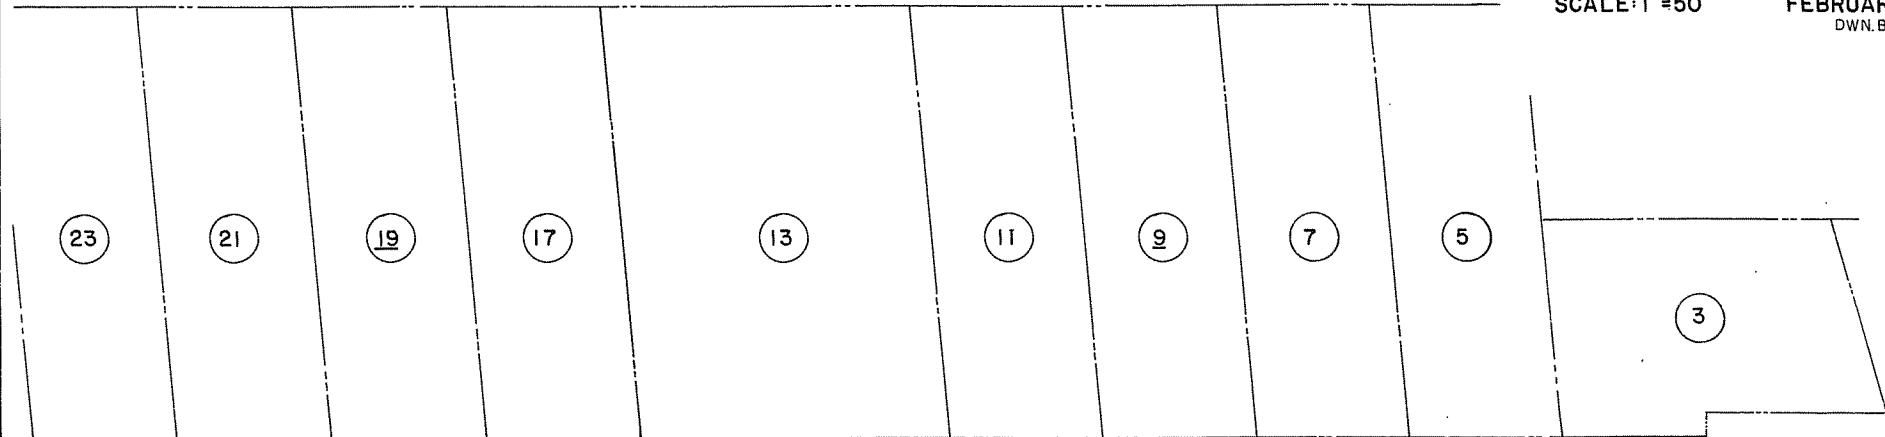

HERBER

AVENUE

