


LEGEND

- CATCH BASIN
- MANHOLE
- ⬇️ HYDRANT
- GATE VALVE
- ⊥ TEE
- ▲ THRUST BLOCK
- W— WATER MAIN

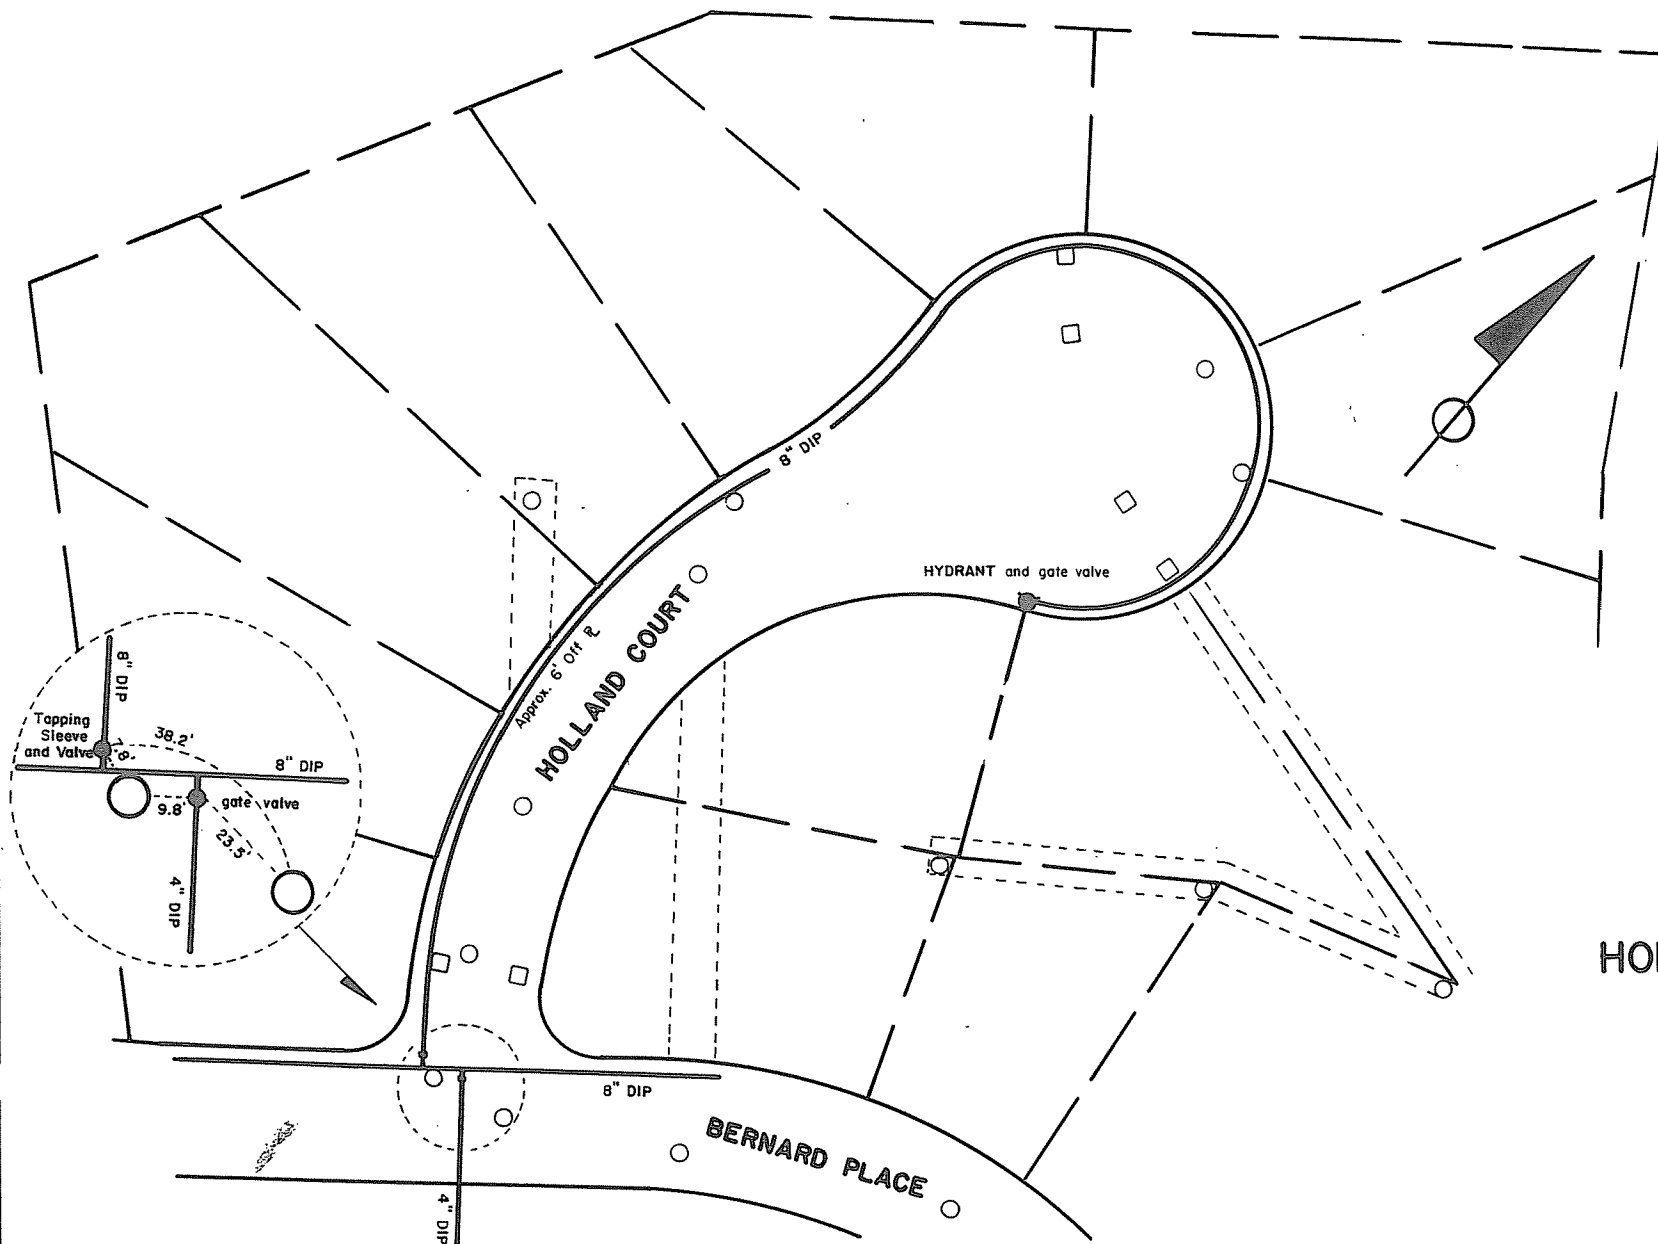

HOLLAND COURT
 WATER MAIN
 JUNE 1985
 1" = 50'
 J. CROSS EXCAVATION