


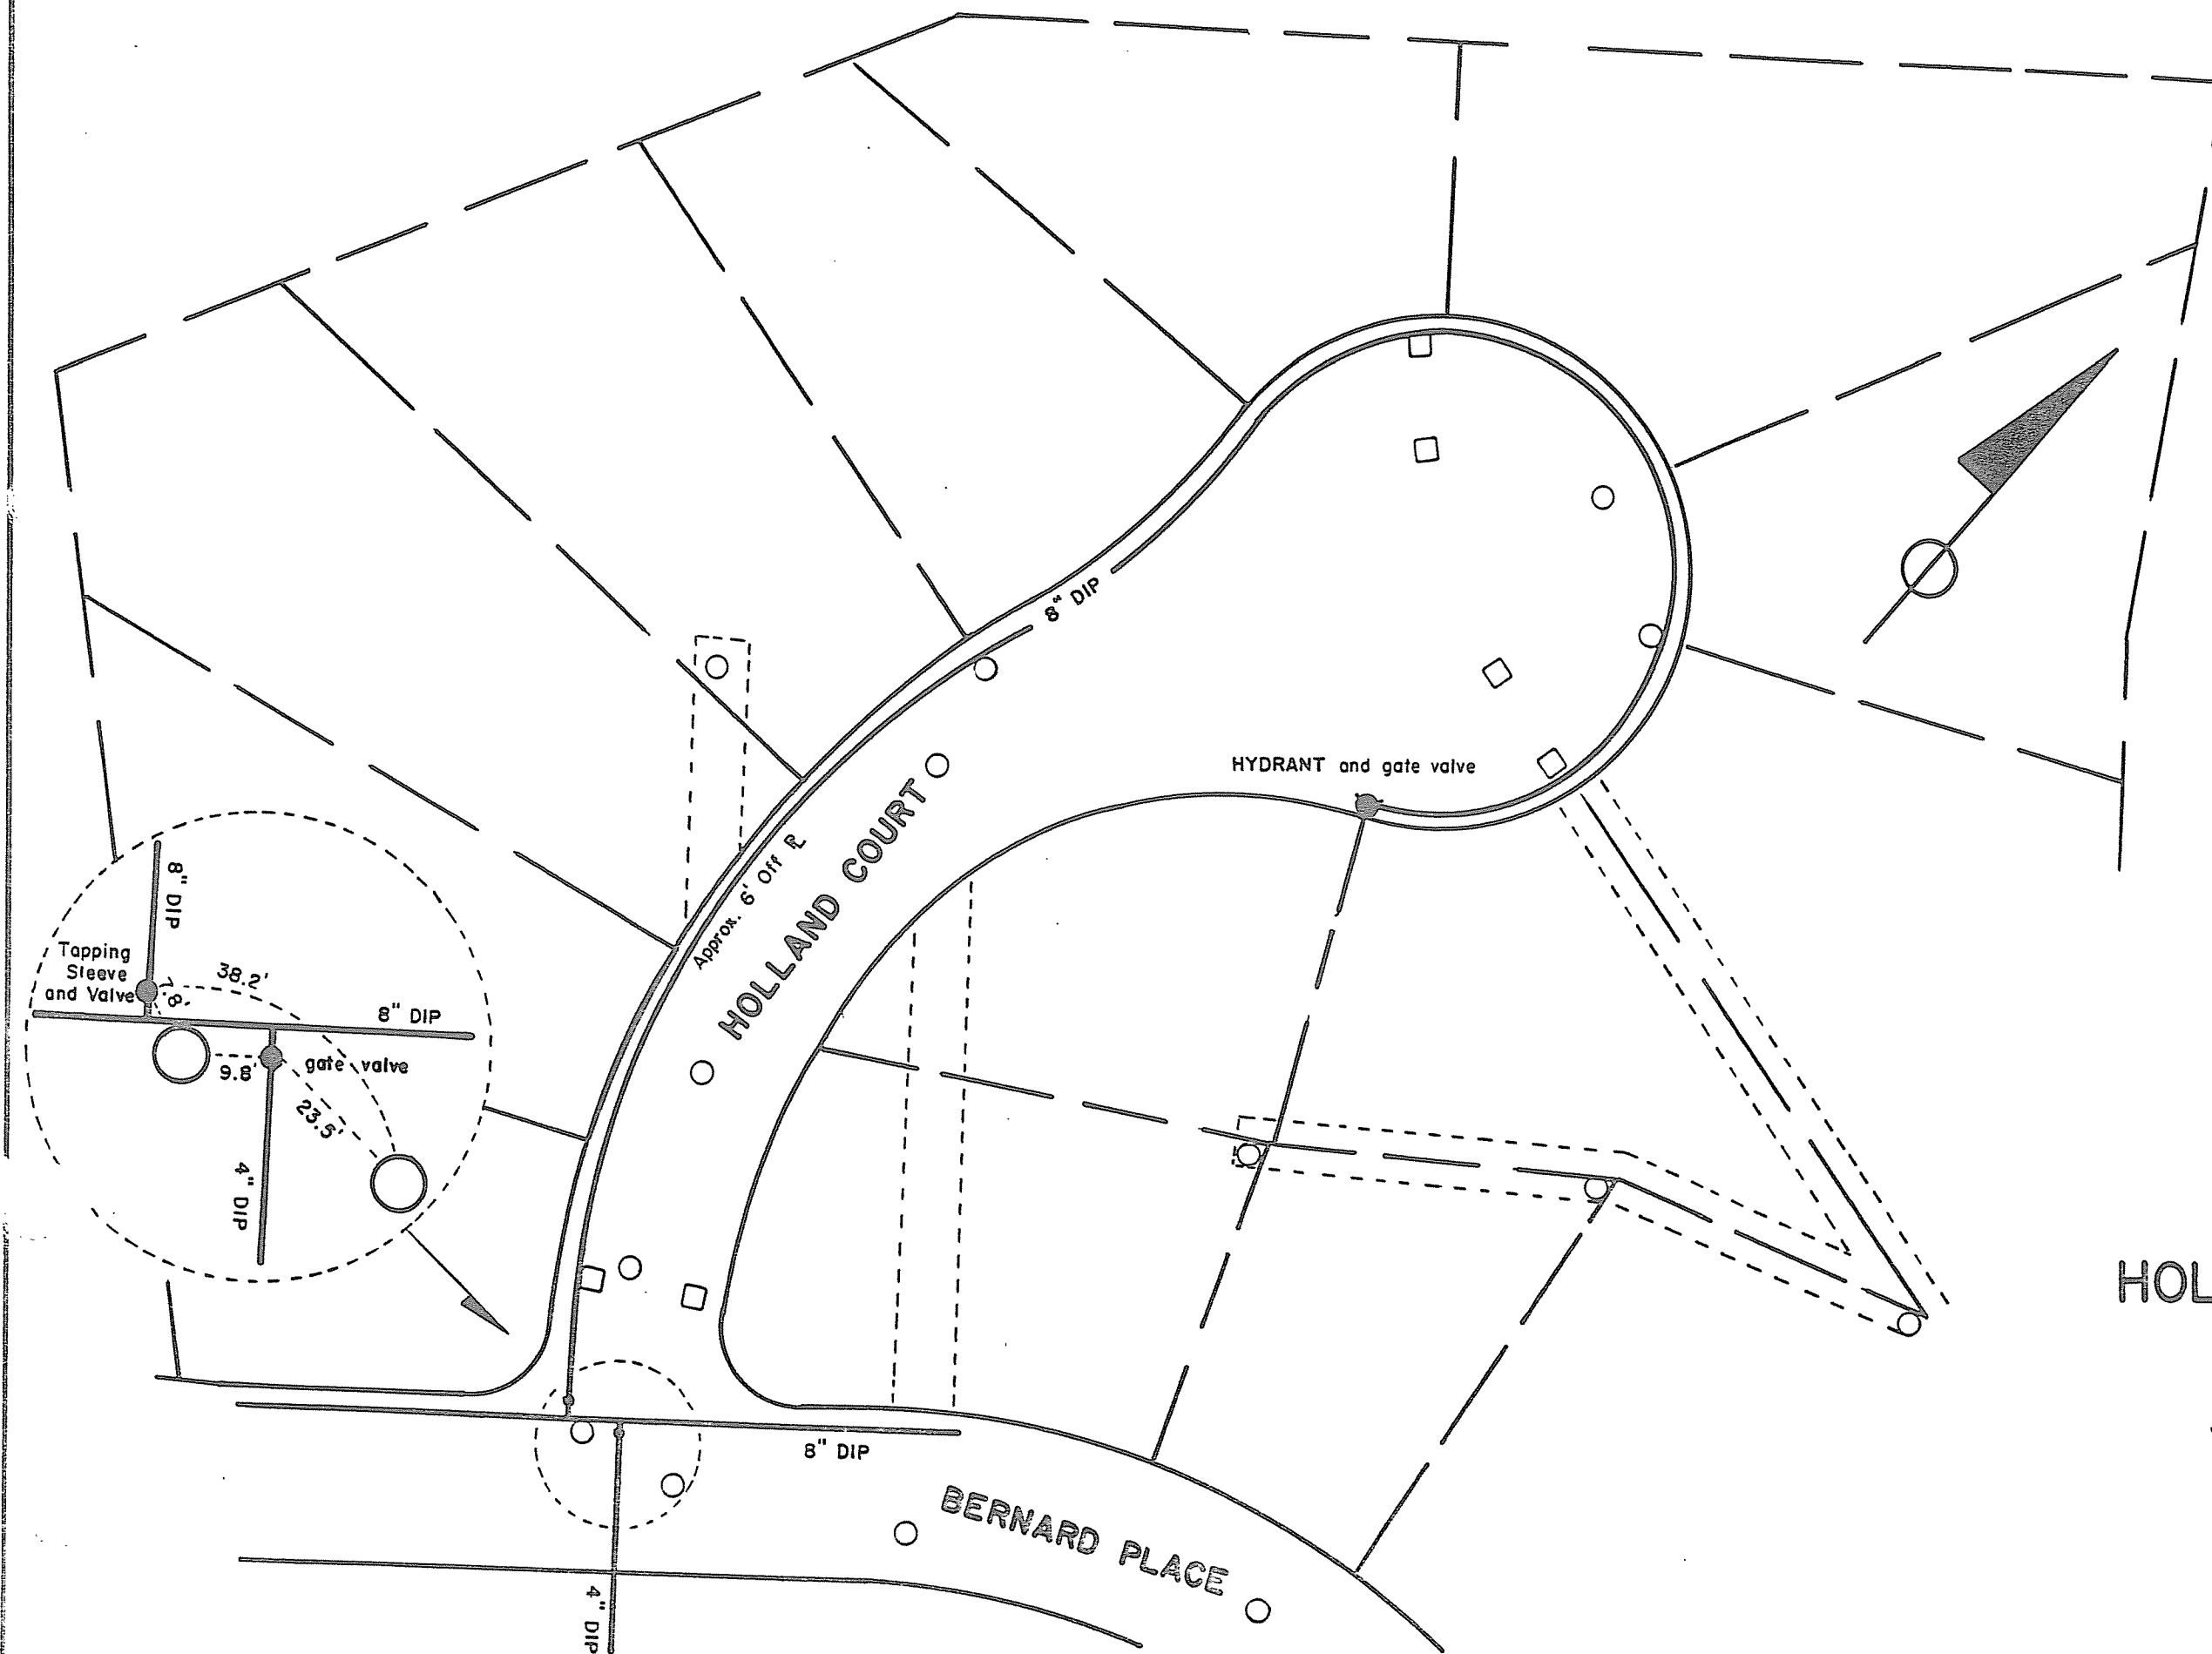

HOLLAND COURT
WATER MAIN
JUNE 1985
1" = 50'
J. CROSS EXCAVATION