


HUDSON AVENUE
WATER DISTRICT NO. 1
TOWN OF BETHLEHEM
RECORD OF INSTALLATION
TOWN OF BETHLEHEM ENGINEERING
DEPARTMENT
SCALE: 1" = 50' NOVEMBER, 1982
DWN. BY: PDH

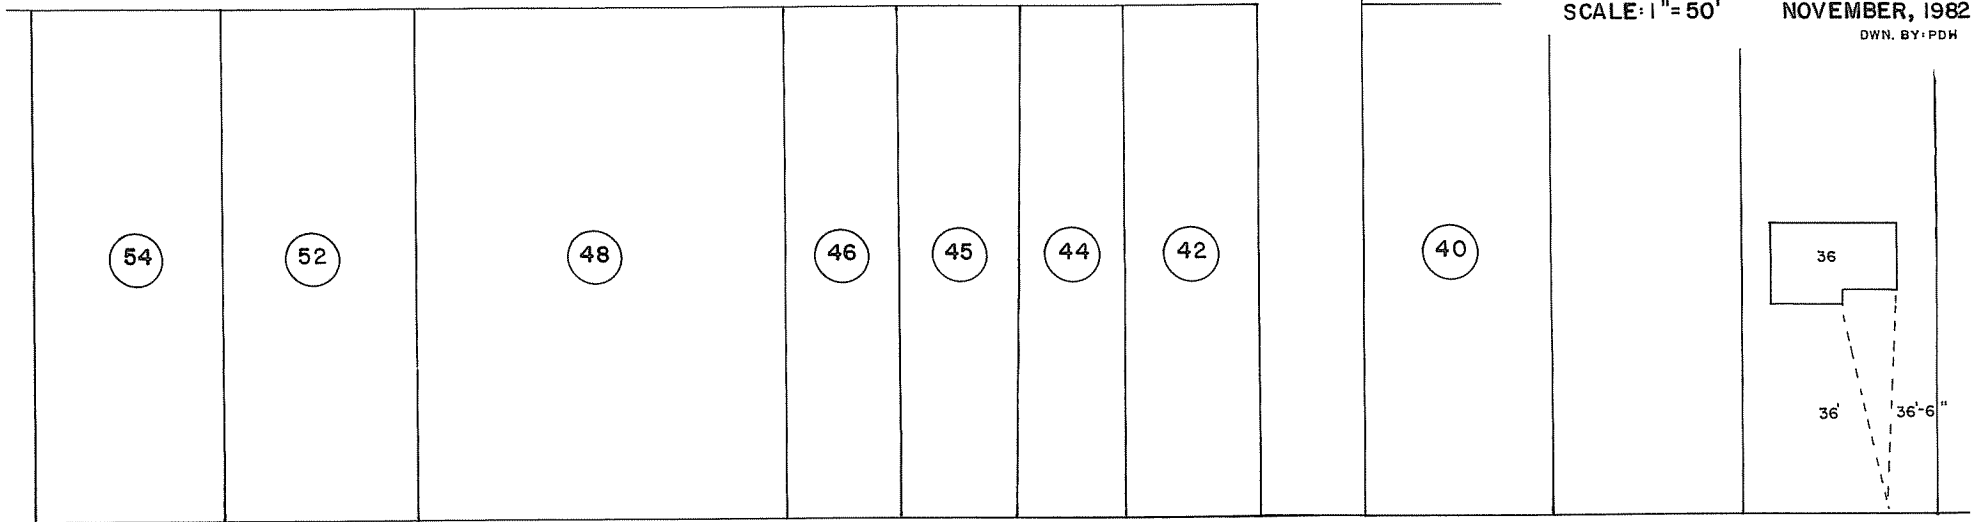

HUDSON

AVENUE

DELAWARE

AND

HUDSON

RAILROAD