

HUDSON AVENUE

WATER DISTRICT NO. I

TOWN OF BETHLEHEM


**RECORD OF INSTALLATION**

TOWN OF BETHLEHEM ENGINEERING

DEPARTMENT

SCALE: 1"=50' NOVEMBER, 1982

N

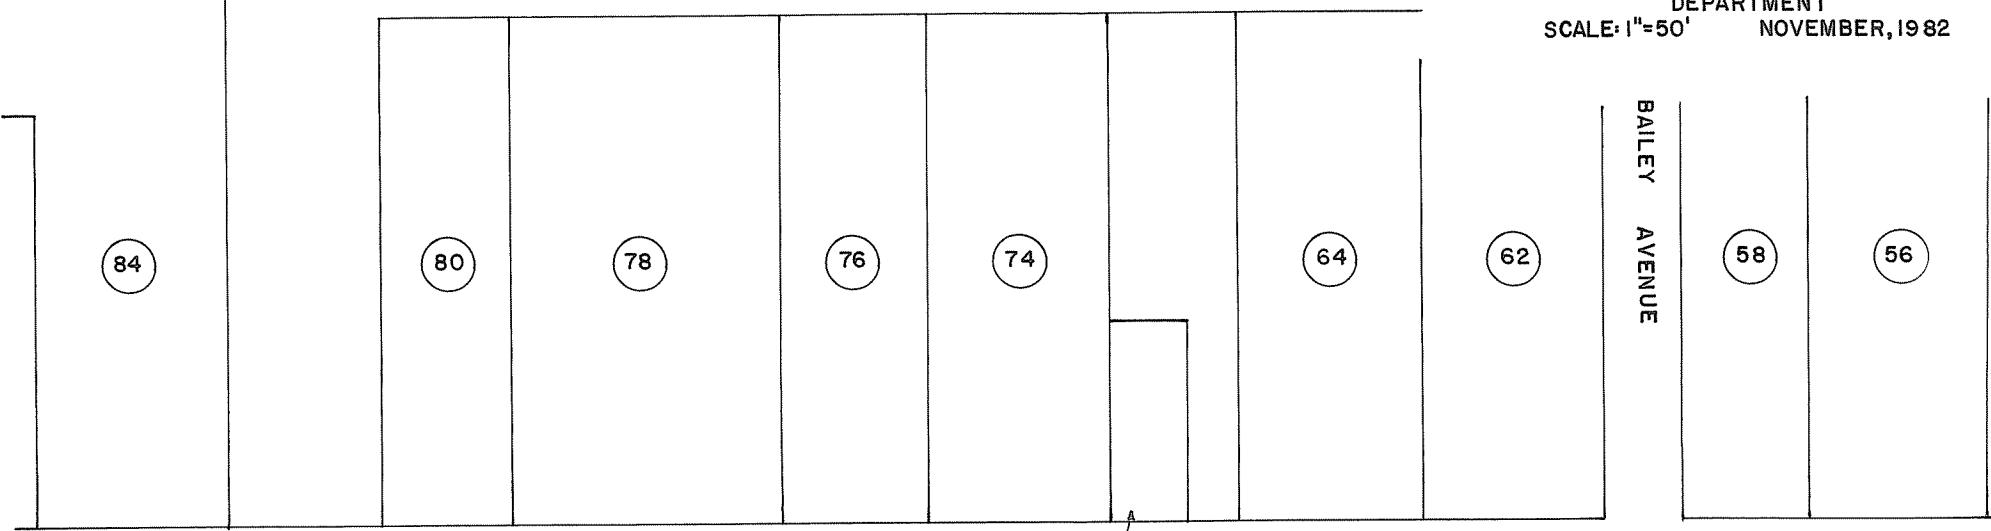

HUDSON

AVENUE

DELAWARE

AND

HUDSON

RAILROAD

BAILEY AVENUE