

HUDSON AVENUE


WATER DISTRICT NO.1

TOWN OF BETHLEHEM

RECORD OF INSTALLATION

TOWN OF BETHLEHEM ENGINEERING
DEPARTMENT

SCALE: 1"=50' NOVEMBER, 1982
DWN. BY: PDH

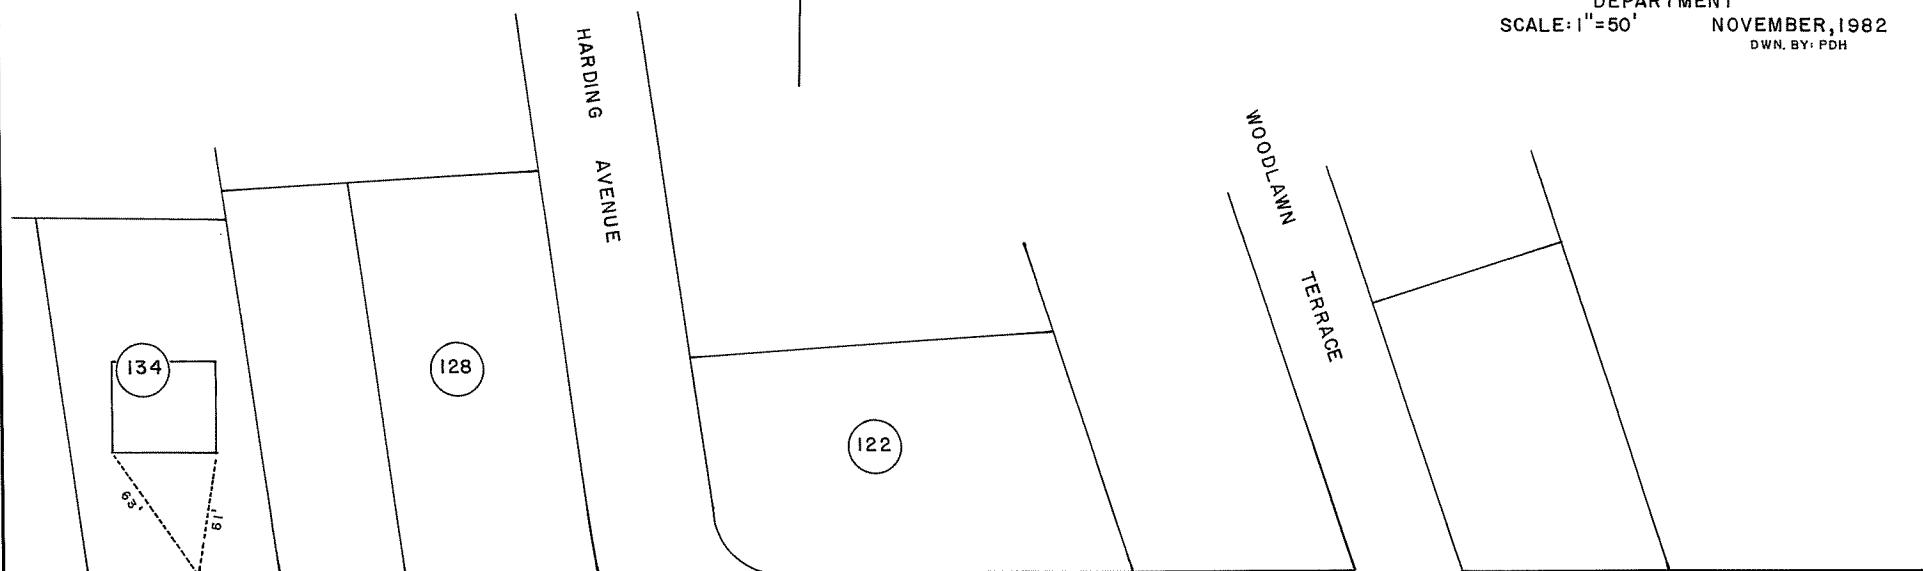

DELAWARE

AND

HUDSON

RAILROAD