


HUDSON AVENUE  
WATER DISTRICT NO.1  
TOWN OF BETHLEHEM  
**RECORD OF INSTALLATION**  
TOWN OF BETHLEHEM ENGINEERING  
DEPARTMENT  
SCALE: 1" = 50'      NOVEMBER, 1982  
DWN. BY: PDH

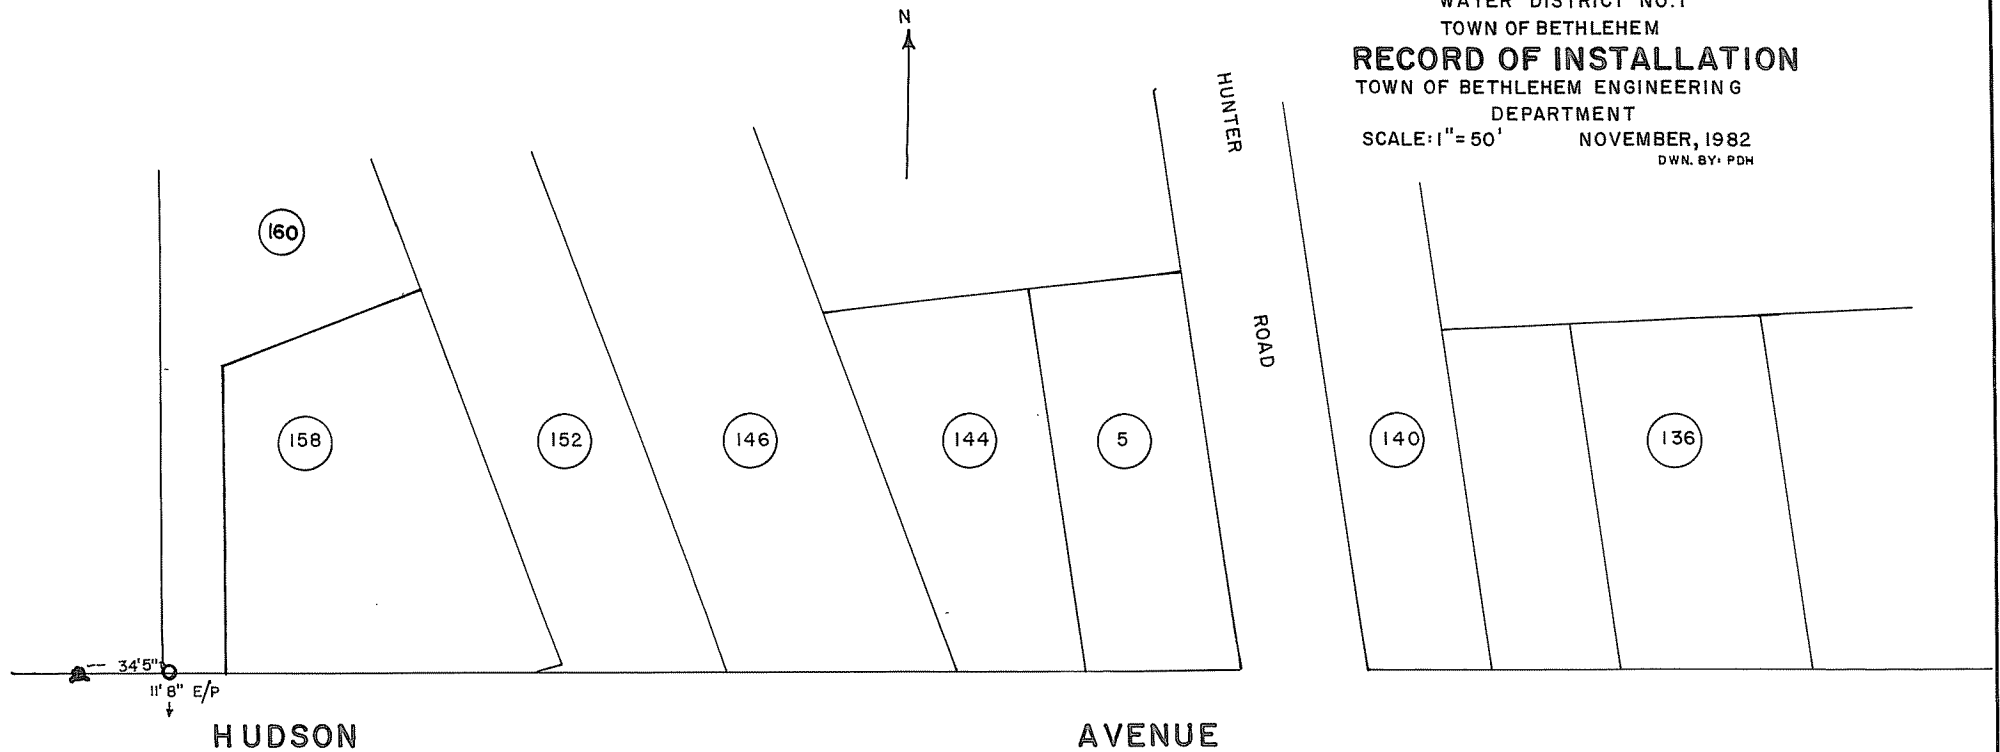

DELAWARE

AND

HUDSON

RAILROAD