

HUDSON AVENUE

WATER DISTRICT NO. 1

TOWN OF BETHLEHEM

RECORD OF INSTALLATION

TOWN OF BETHLEHEM ENGINEERING


DEPARTMENT

SCALE: 1"=50'

NOVEMBER, 1982

DWN. BY: PDH

N

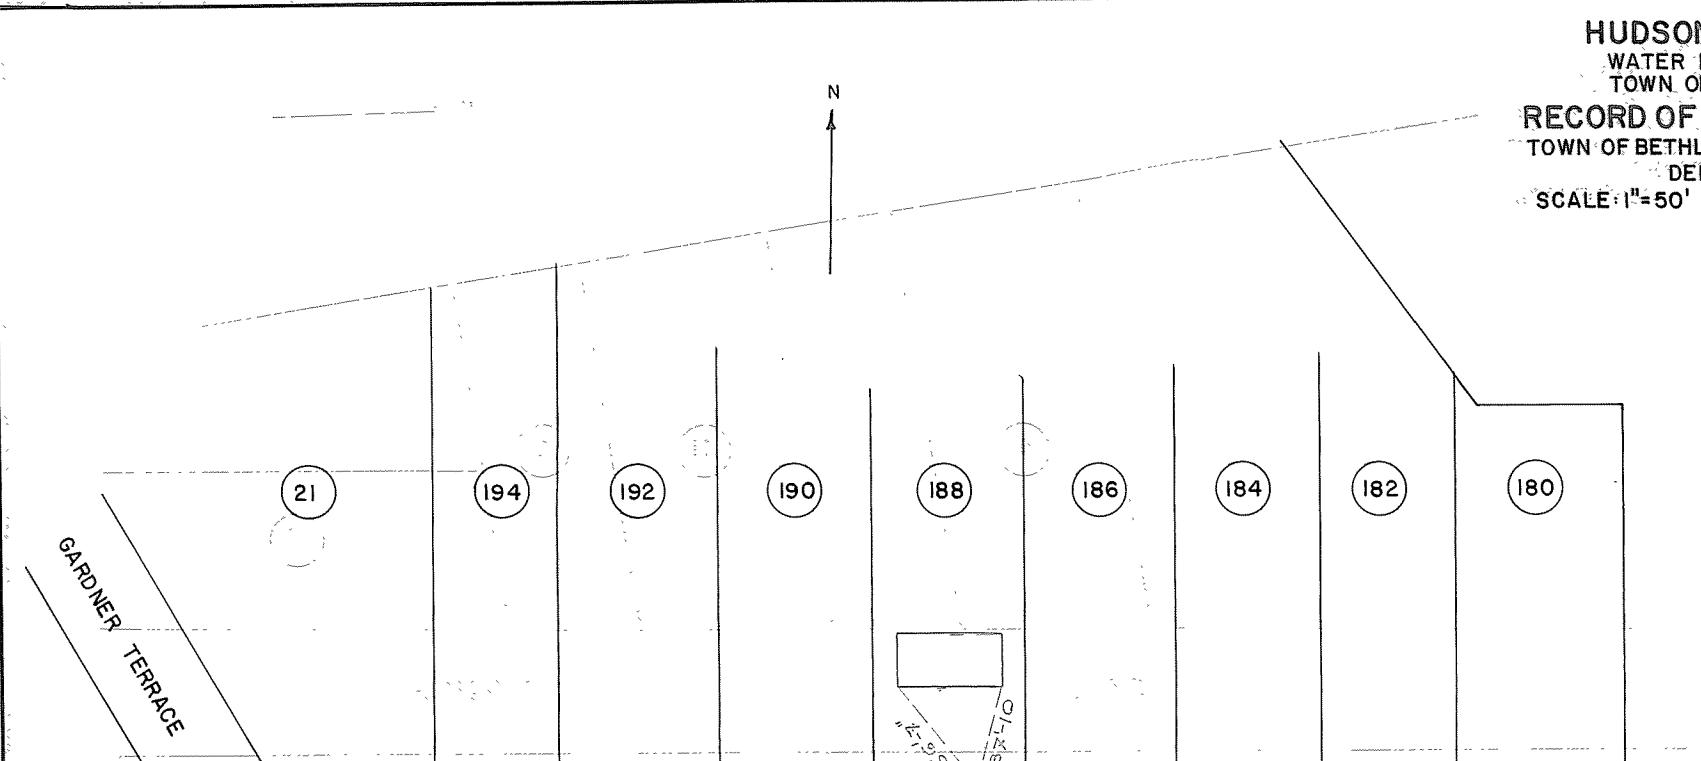

HUDSON

AVENUE

DELAWARE

AND

HUDSON

RAILROAD

1/4