
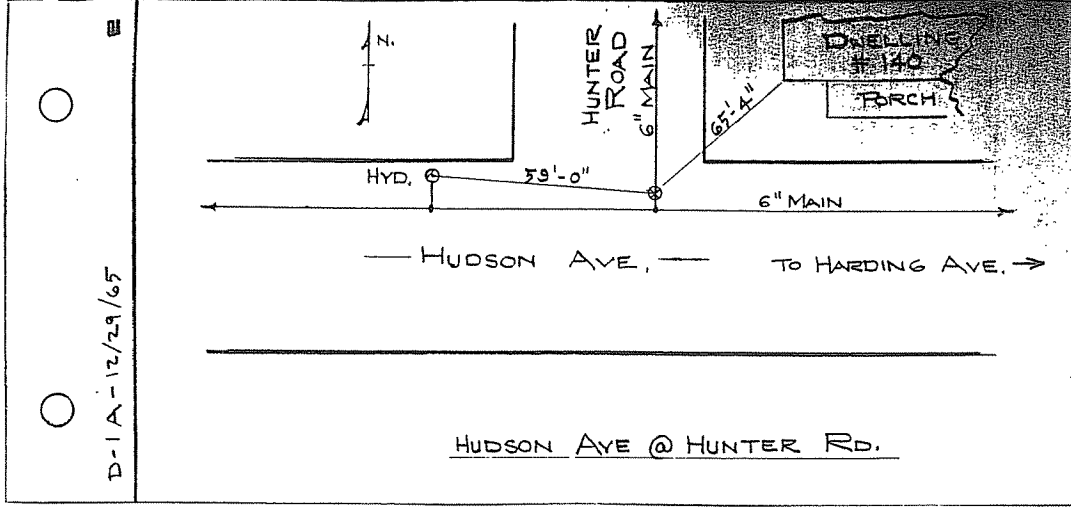


10-10-65

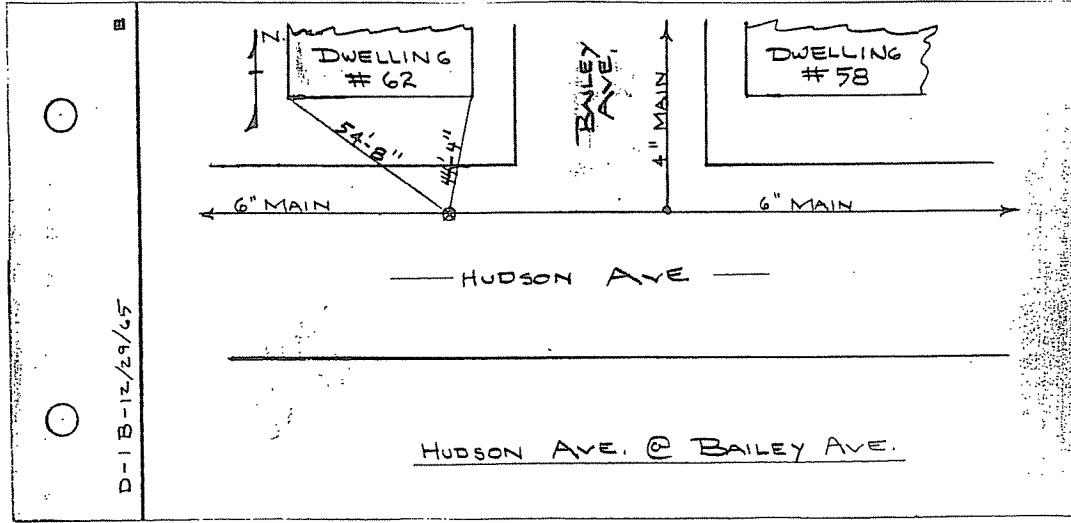

HUDSON AVENUE