

HUNTER ROAD

WATER DISTRICT NO.1

TOWN OF BETHLEHEM


RECORD OF INSTALLATION

TOWN OF BETHLEHEM ENGINEERING
DEPARTMENT

SCALE: 1"=50' DECEMBER, 1982

DWN.BY: PDH

→ N

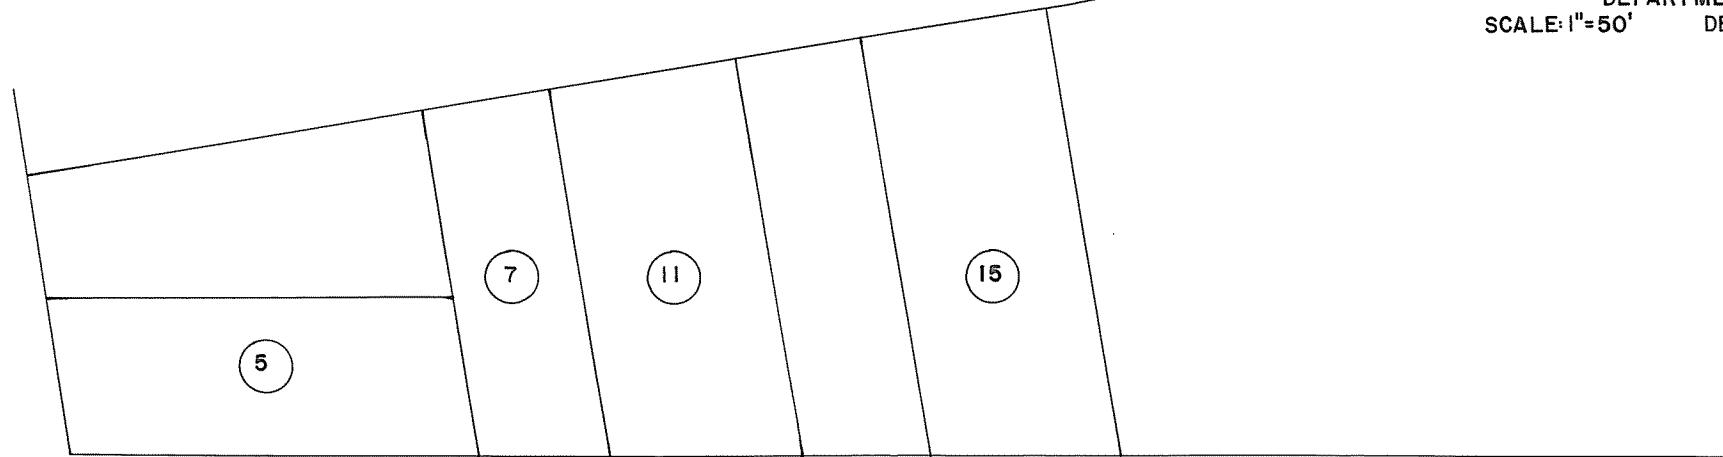

HUNTER

ROAD

