


HUNTER ROAD  
WATER DISTRICT NO. 1  
TOWN OF BETHLEHEM  
**RECORD OF INSTALLATION**  
TOWN OF BETHLEHEM ENGINEERING  
DEPARTMENT

SCALE: 1"=50'


DECEMBER, 1982

DW, BY: PDH

→ N

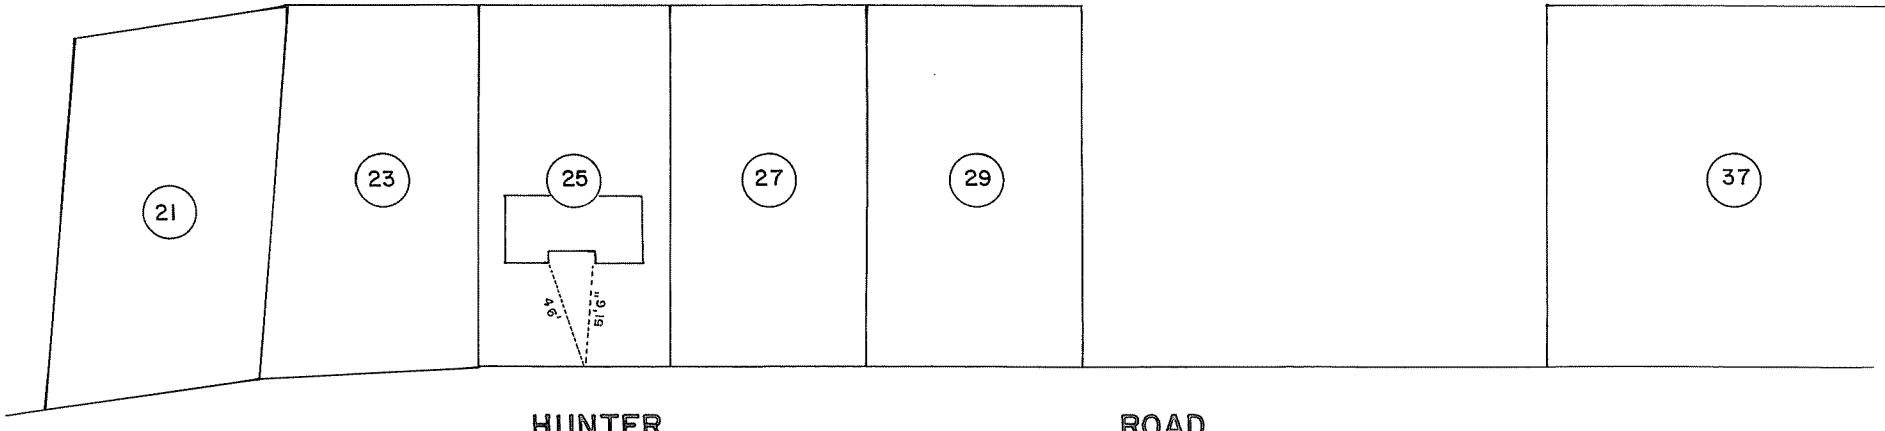

HUNTER ROAD

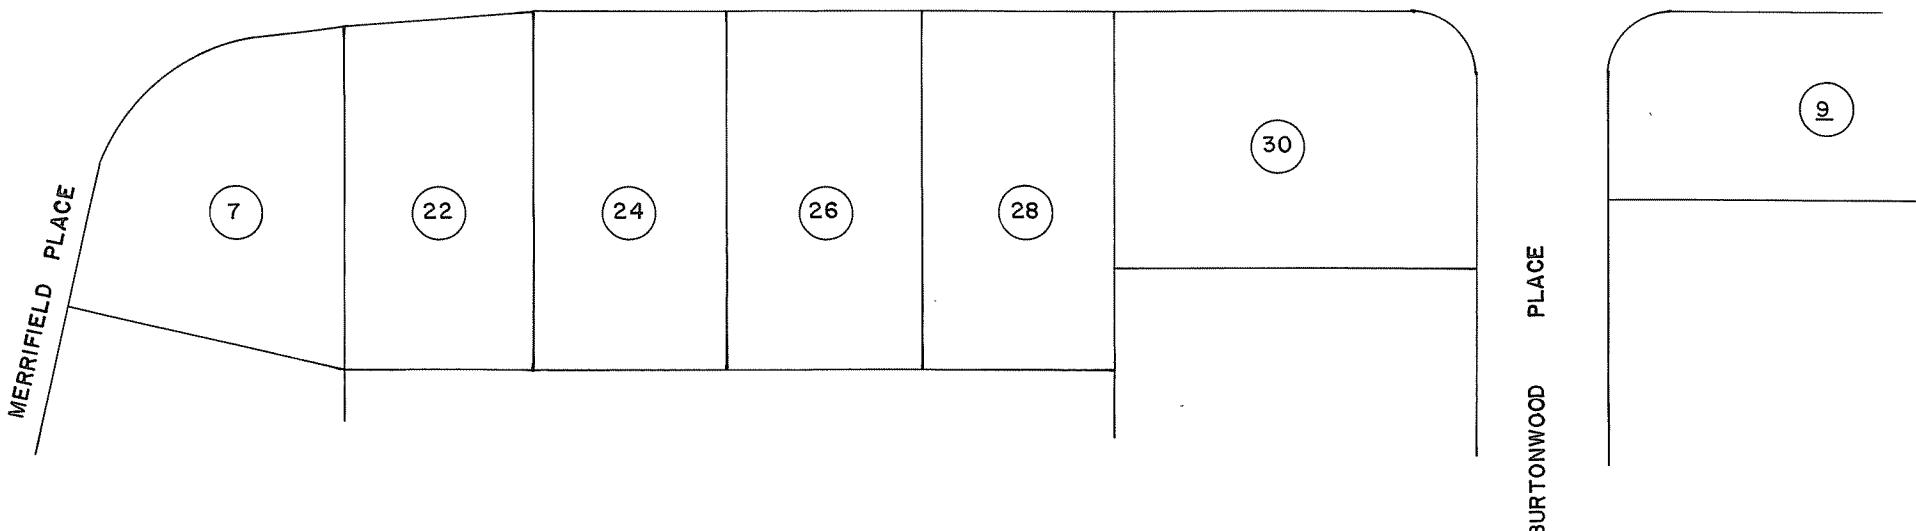

MERRIFIELD PLACE

BURTONWOOD PLACE