


✓ HURON ROAD
"KENAWARE"
WATER DISTRICT NO. 1
TOWN OF BETHLEHEM

RECORD OF INSTALLATION
TOWN OF BETHLEHEM ENGINEERING
DEPARTMENT

SCALE: 1" = 50' FEBRUARY, 1982
DWN. BY: PDH

N

AVENUE

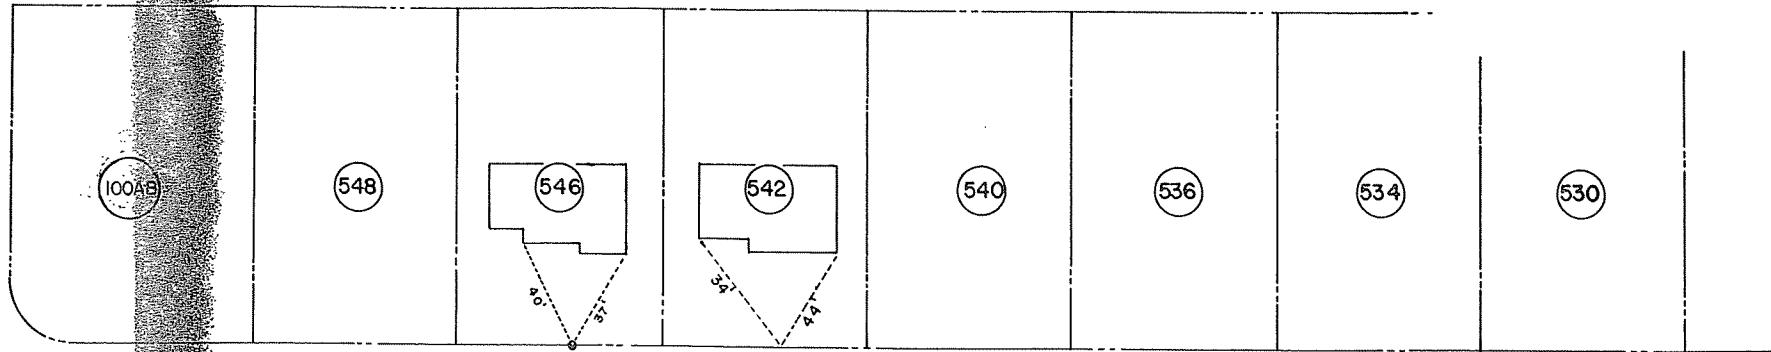

CHERRY

HURON

ROAD

CARSON ROAD

68

535

533

ST. CLAIR DRIVE

