

HURON ROAD
"KENAWARE"

WATER DISTRICT NO. I
TOWN OF BETHLEHEM

RECORD OF INSTALLATION
TOWN OF BETHLEHEM ENGINEERING


DEPARTMENT

SCALE: 1" = 50' FEBRUARY, 1982

DWN. BY: PDH

N


AVENUE

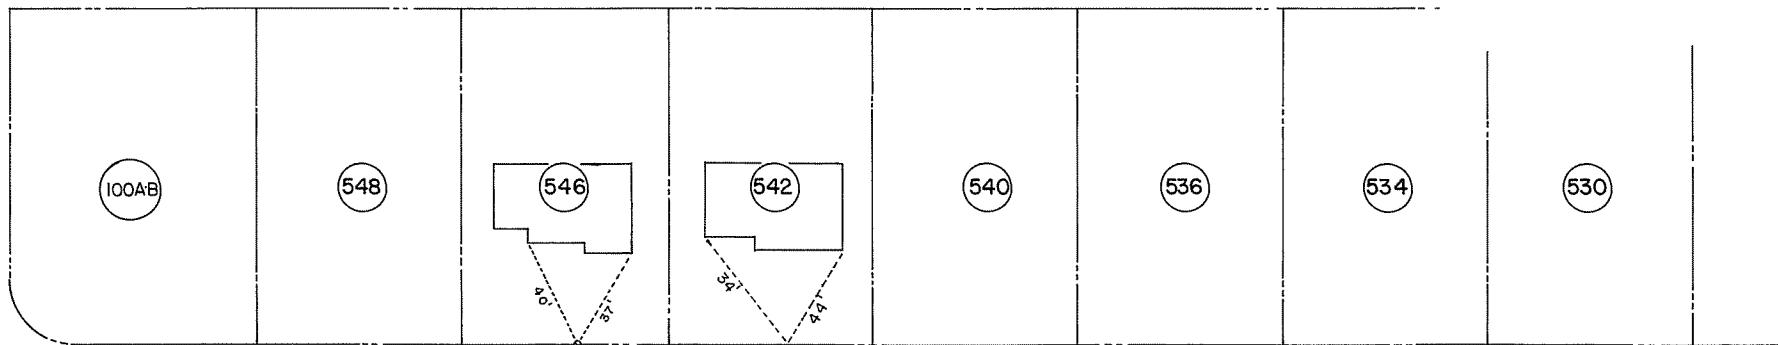

HURON

ROAD

CHERRY

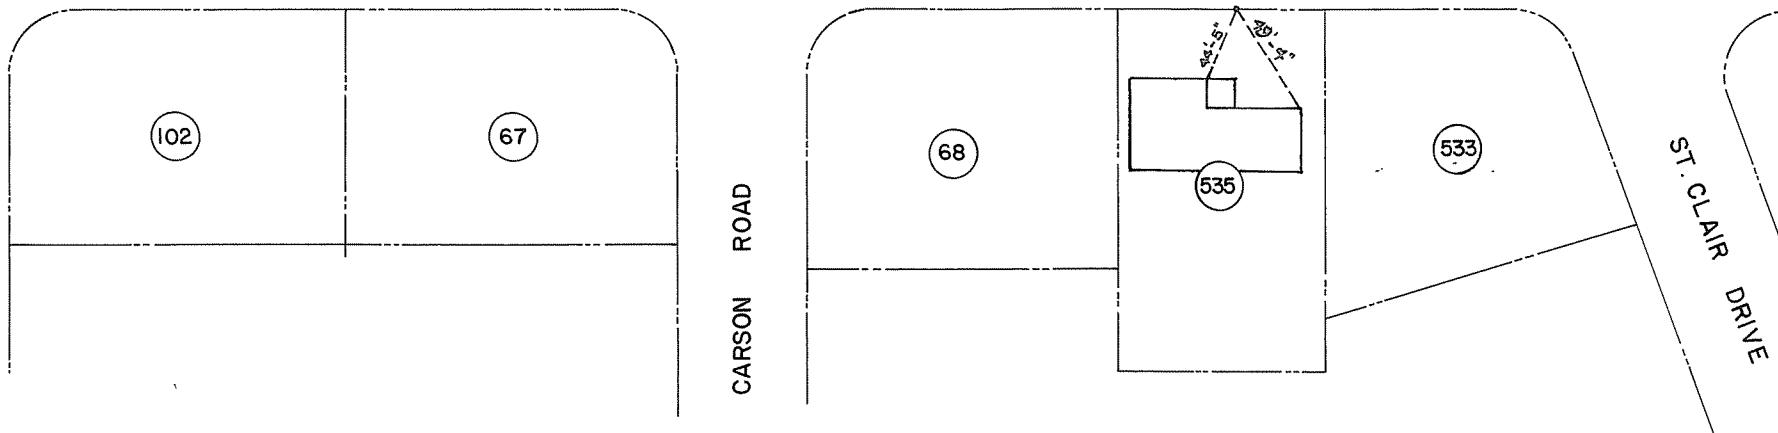

ST. CLAIR DRIVE