


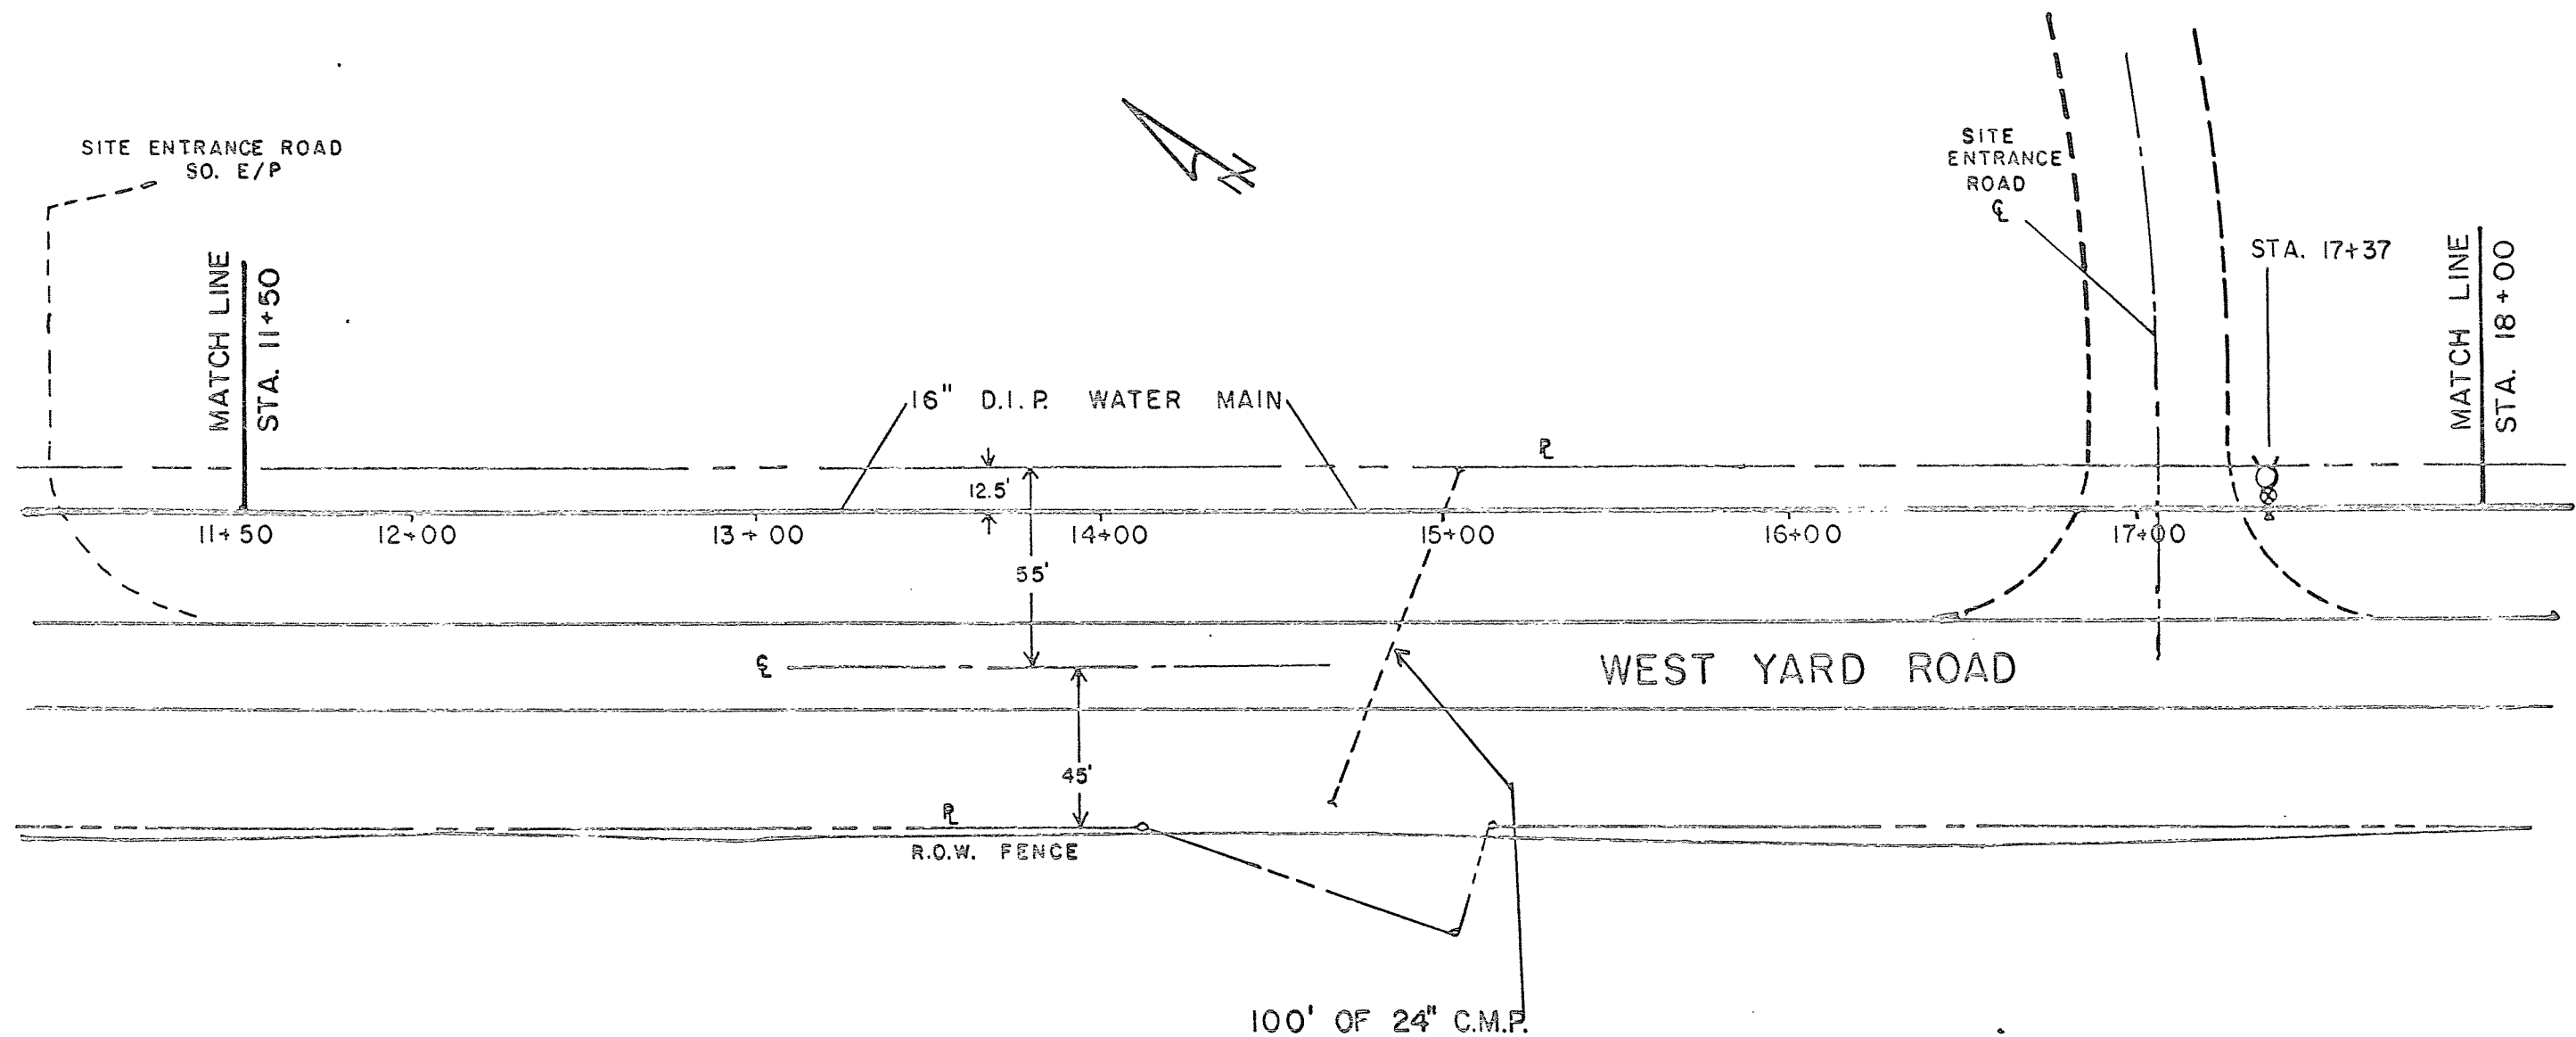

INDUSTRIAL AREA - FEURA BUSH
 EXTENSION NO. 4
 WATER DISTRICT NO. 1
 TOWN OF BETHLEHEM
 RECORD OF INSTALLATION
 SCALE 1" = 50' JAN., 1988
 INSTALLED AUGUST, 1986

DRN BY AJL
 CHK BY