
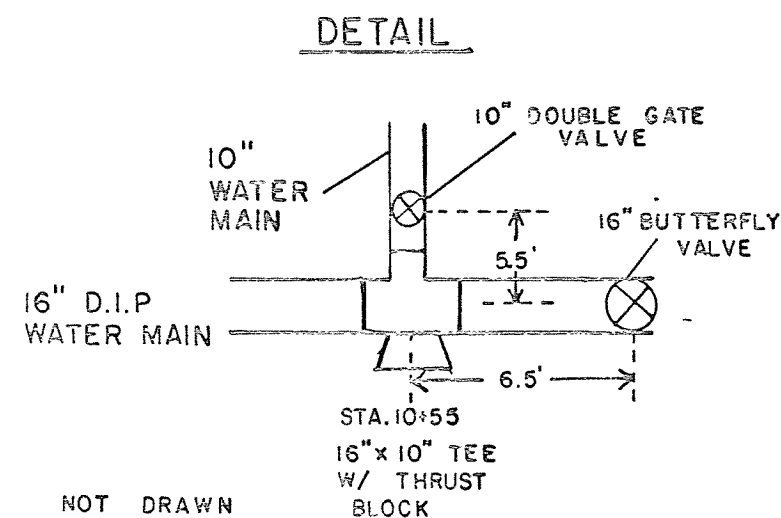


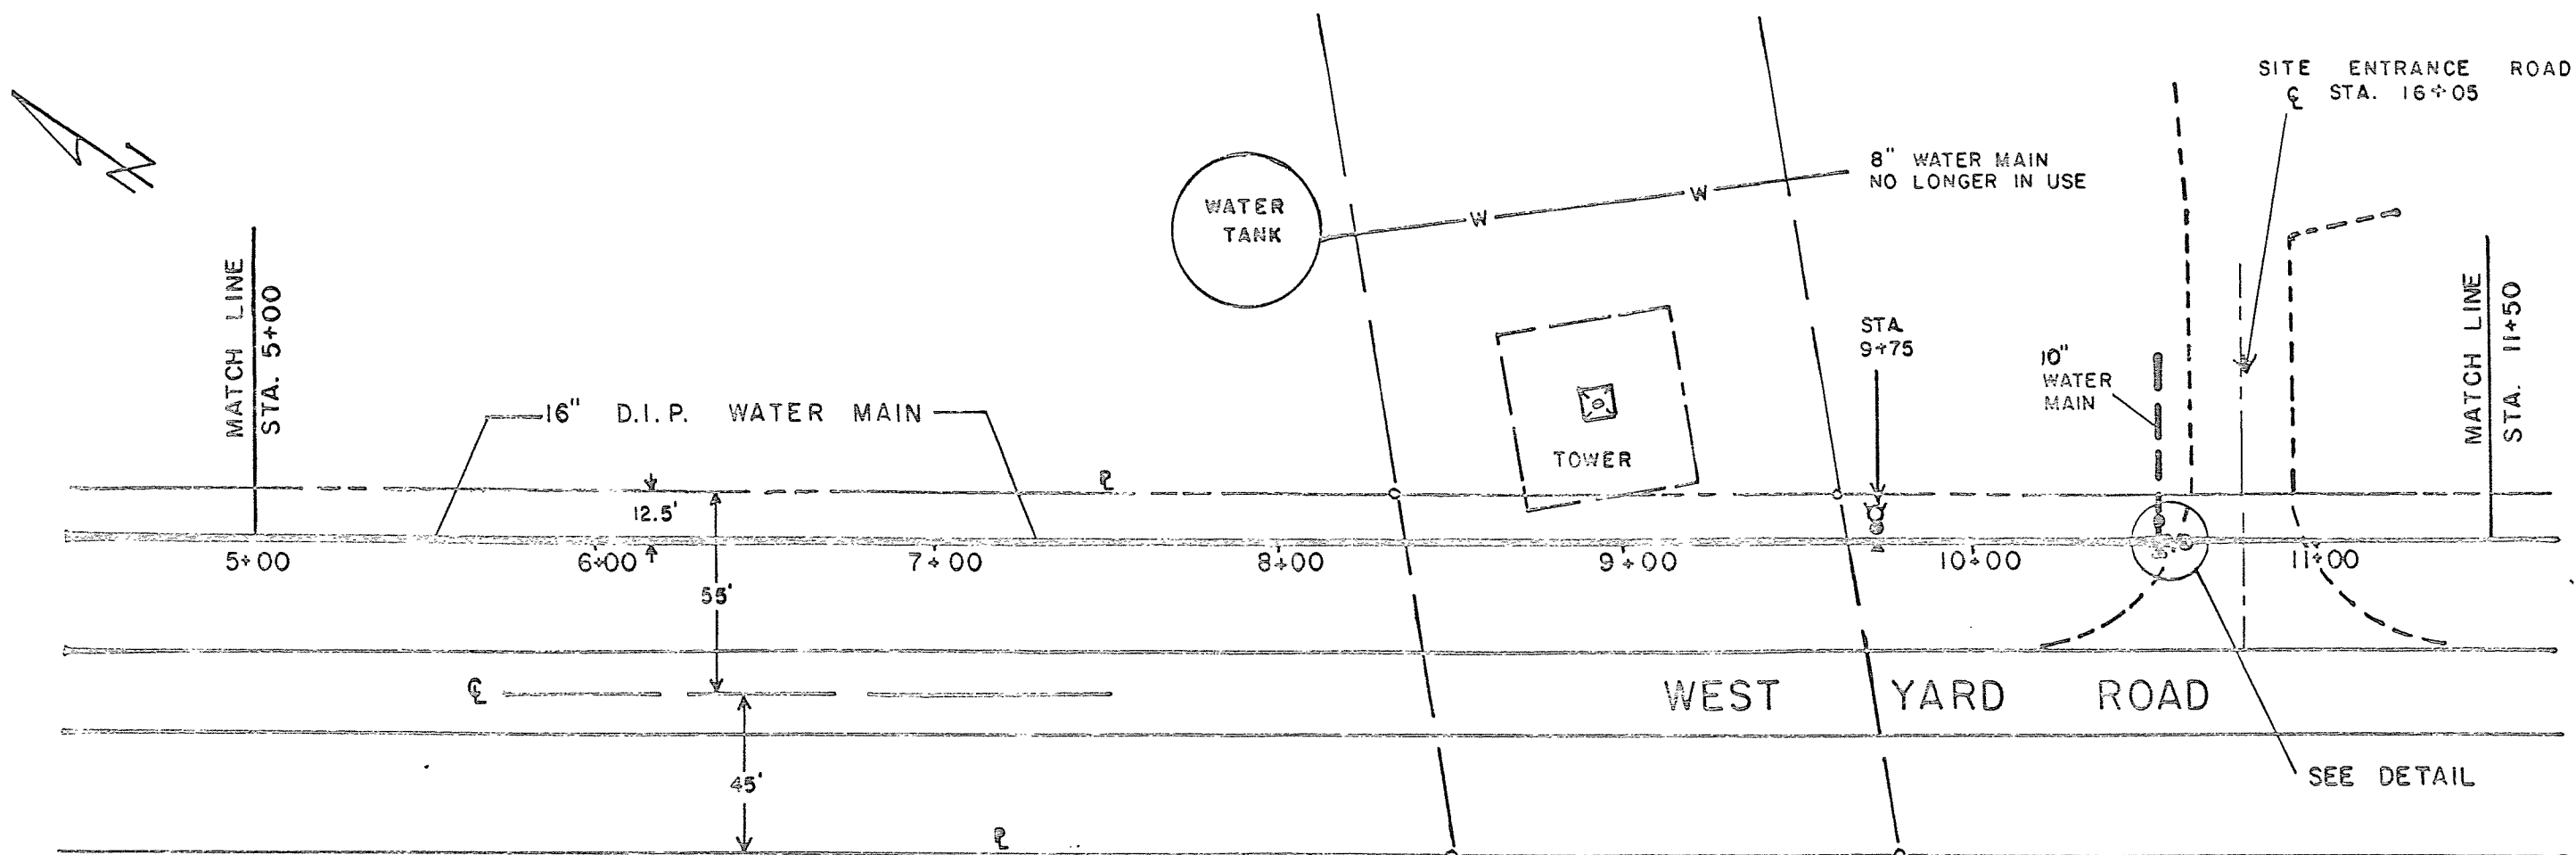

INDUSTRIAL AREA - FEURA BUSH
EXTENSION NO. 4
WATER DISTRICT NO. 1
TOWN OF BETHLEHEM
RECORD OF INSTALLATION
SCALE 1" = 50' DEC., 1987
INSTALLED AUGUST, 1986