
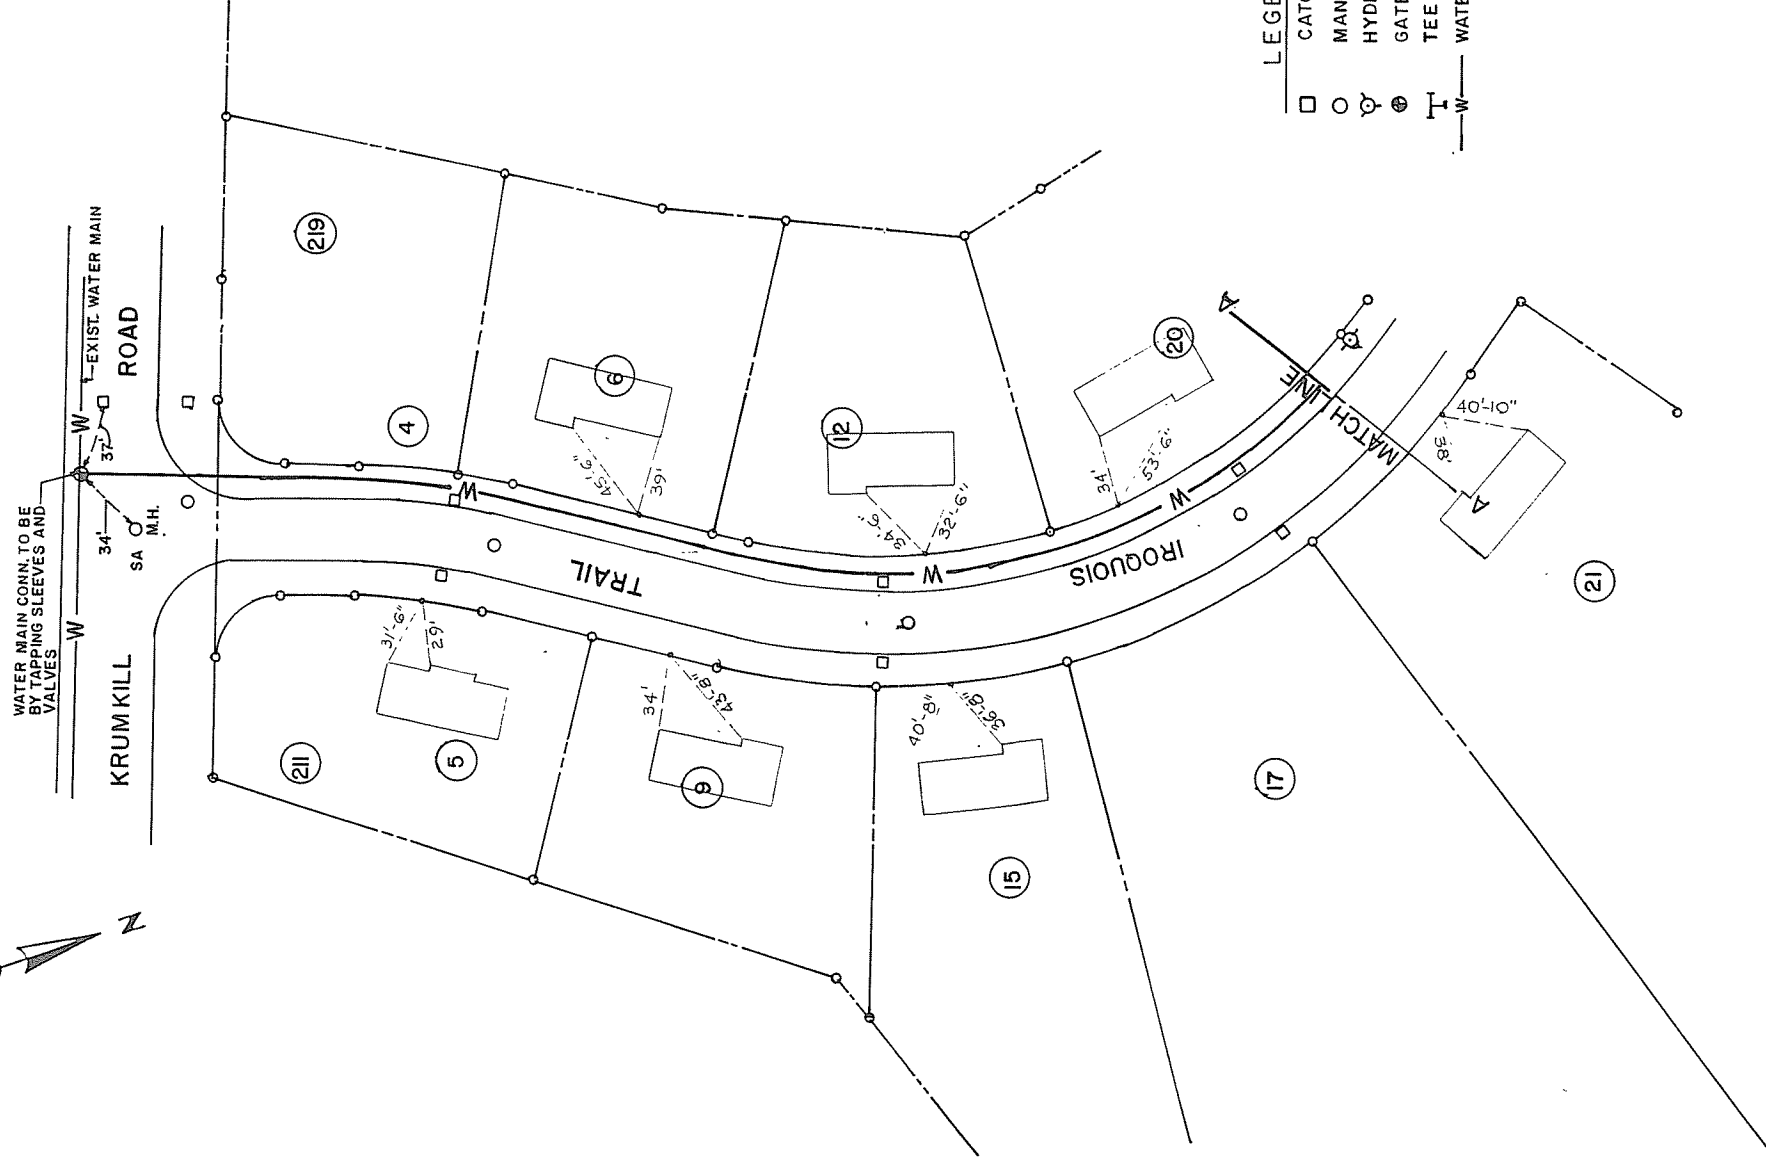


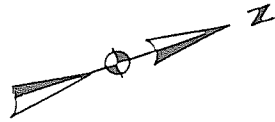

LEGEND	
□	CATCH BASIN
○	MANHOLE
⊗	HYDRANT
⊕	GATE VALVE
T	TEE
—W—	WATER MAIN

IROQUOIS TRAIL
INDIAN HILLS
SECTION No. 3
WATER MAIN & CURB BOXES
SCALE: 1"=50' APRIL 1994

DRAWN BY: M. G.
CHECKED BY: T.W.R.