


LANDS OF
NIAGARA POWER CORPORATION
MOHAWK

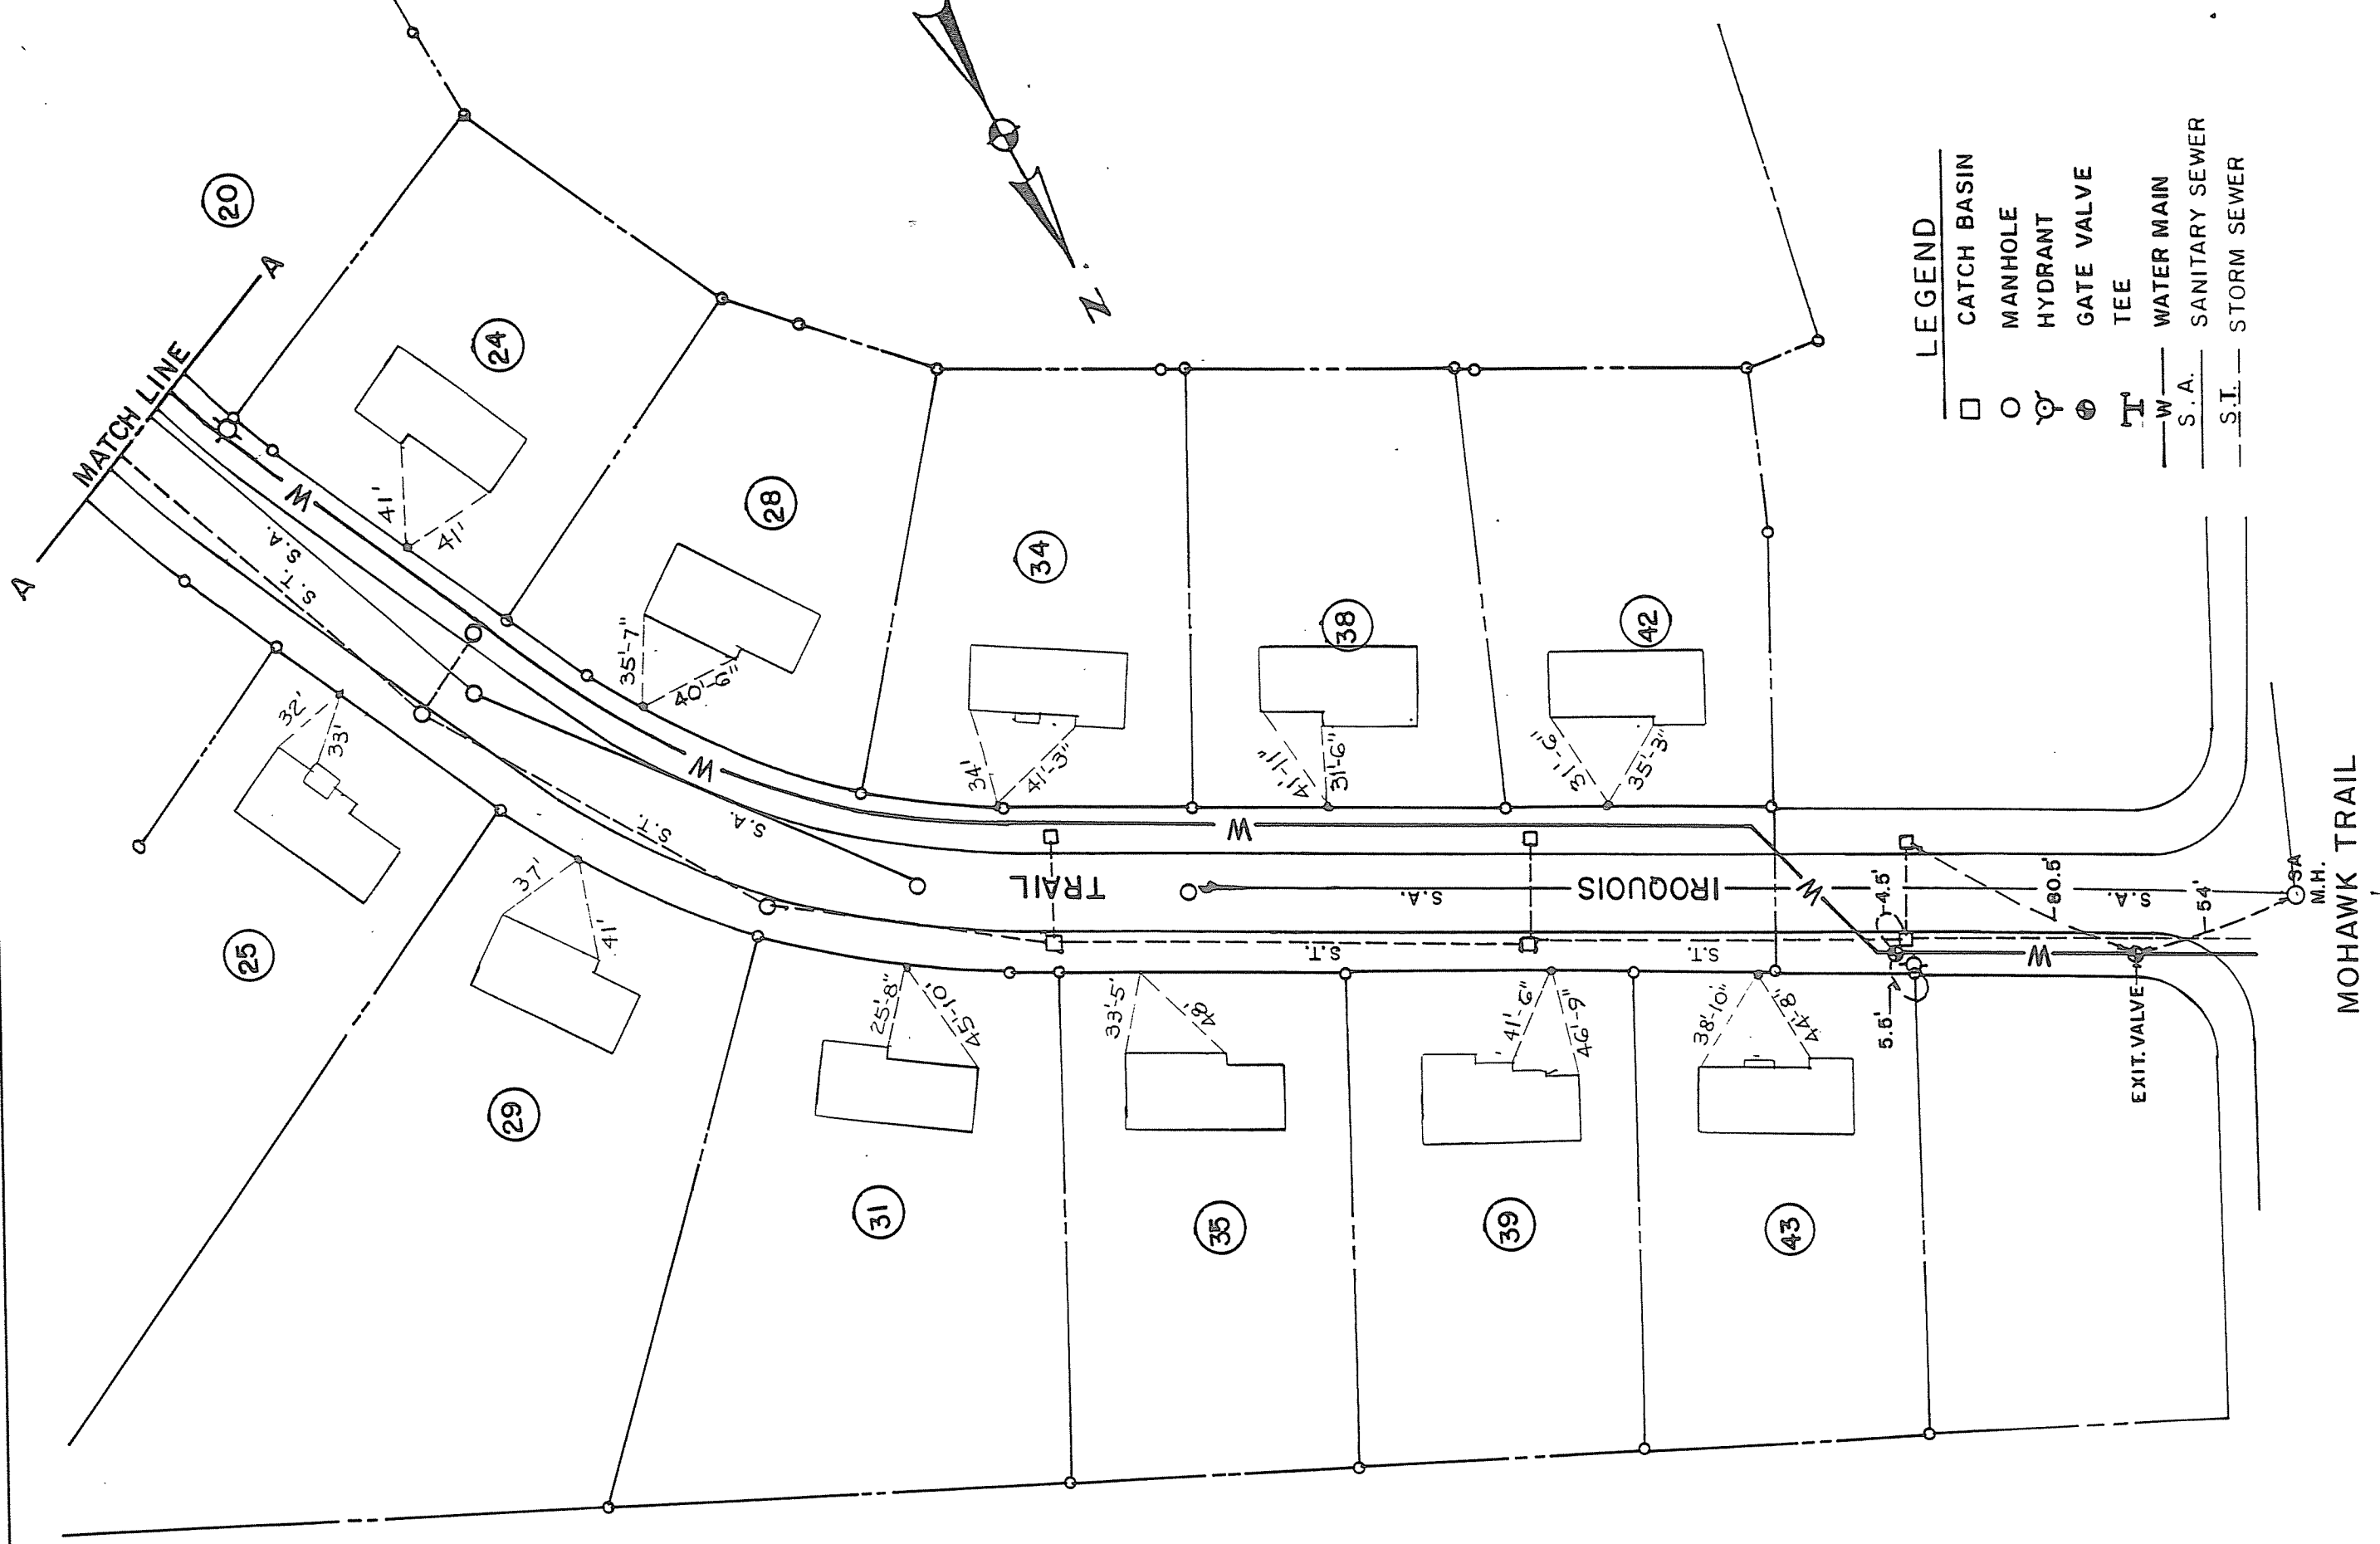

LEGEND

- | | |
|--------|----------------|
| □ | CATCH BASIN |
| ○ | MANHOLE |
| ⊕ | HYDRANT |
| ⊗ | GATE VALVE |
| ⊥ | TEE |
| —W— | WATER MAIN |
| —S.A.— | SANITARY SEWER |
| —S.T.— | STORM SEWER |

MOHAWK TRAIL

IROQUOIS TRAIL
INDIAN HILLS
SECTION No. 3
WATER MAIN & CURB BOXES
1"=50' APRIL 1994

DRAWN BY:
CHECKED BY: W.R.