


LANDS OF
 NIAGARA MOHAWK POWER CORPORATION

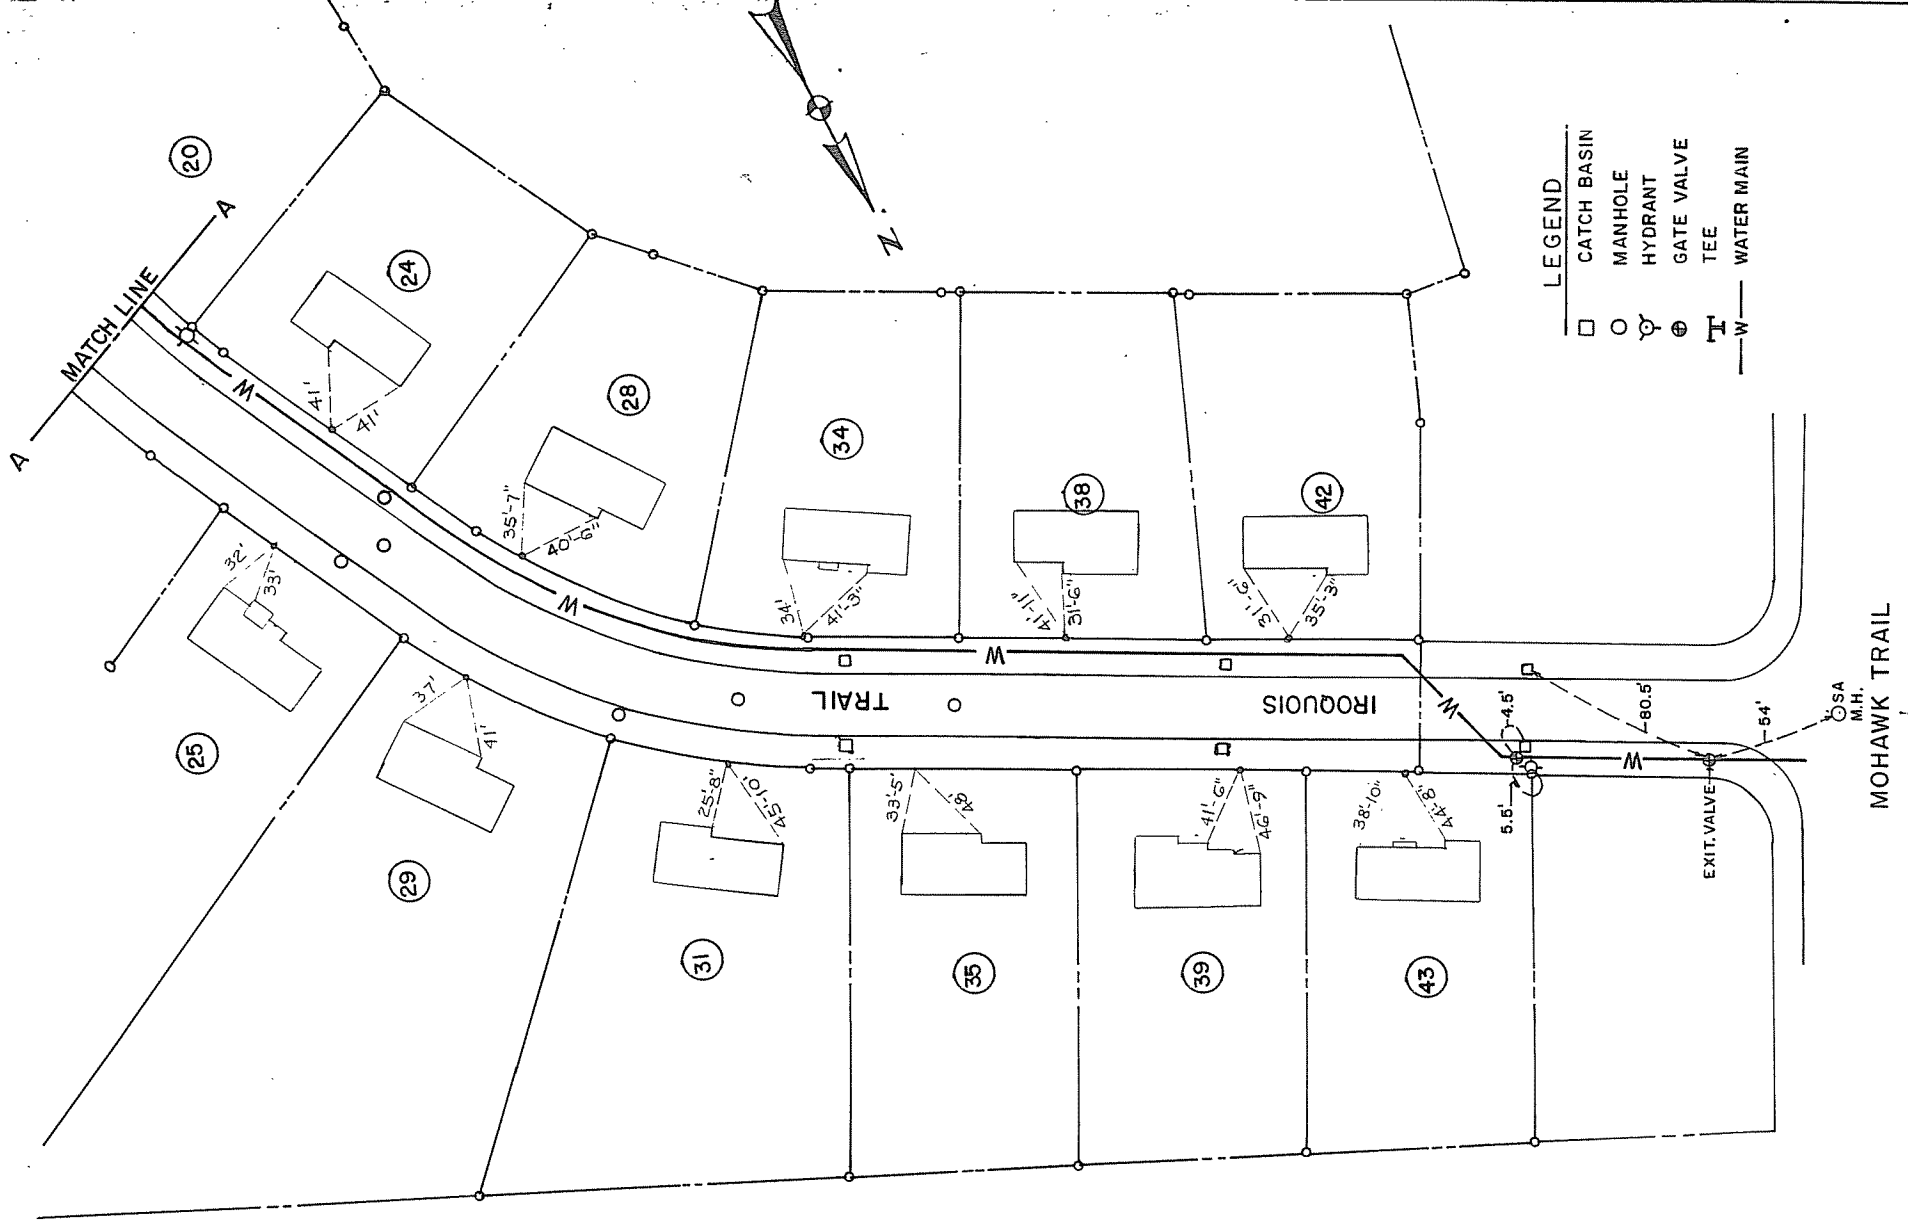

- LEGEND
- CATCH BASIN
 - MANHOLE
 - ⊗ HYDRANT
 - ⊙ GATE VALVE
 - ⊥ TEE
 - W— WATER MAIN

IROQUOIS TRAIL
 INDIAN HILLS
 SECTION No. 3
 WATER MAIN & CURB BOXES
 SCALE: 1"=50' APRIL 1994

DRAWN BY: M.G.
 CHECKED BY: T.W.R.