


WATER MAIN CONN. TO BE
BY TAPPING SLEEVES AND
VALVES

W — EXIST. WATER MAIN

KRUMKILL

ROAD

SA M.H.

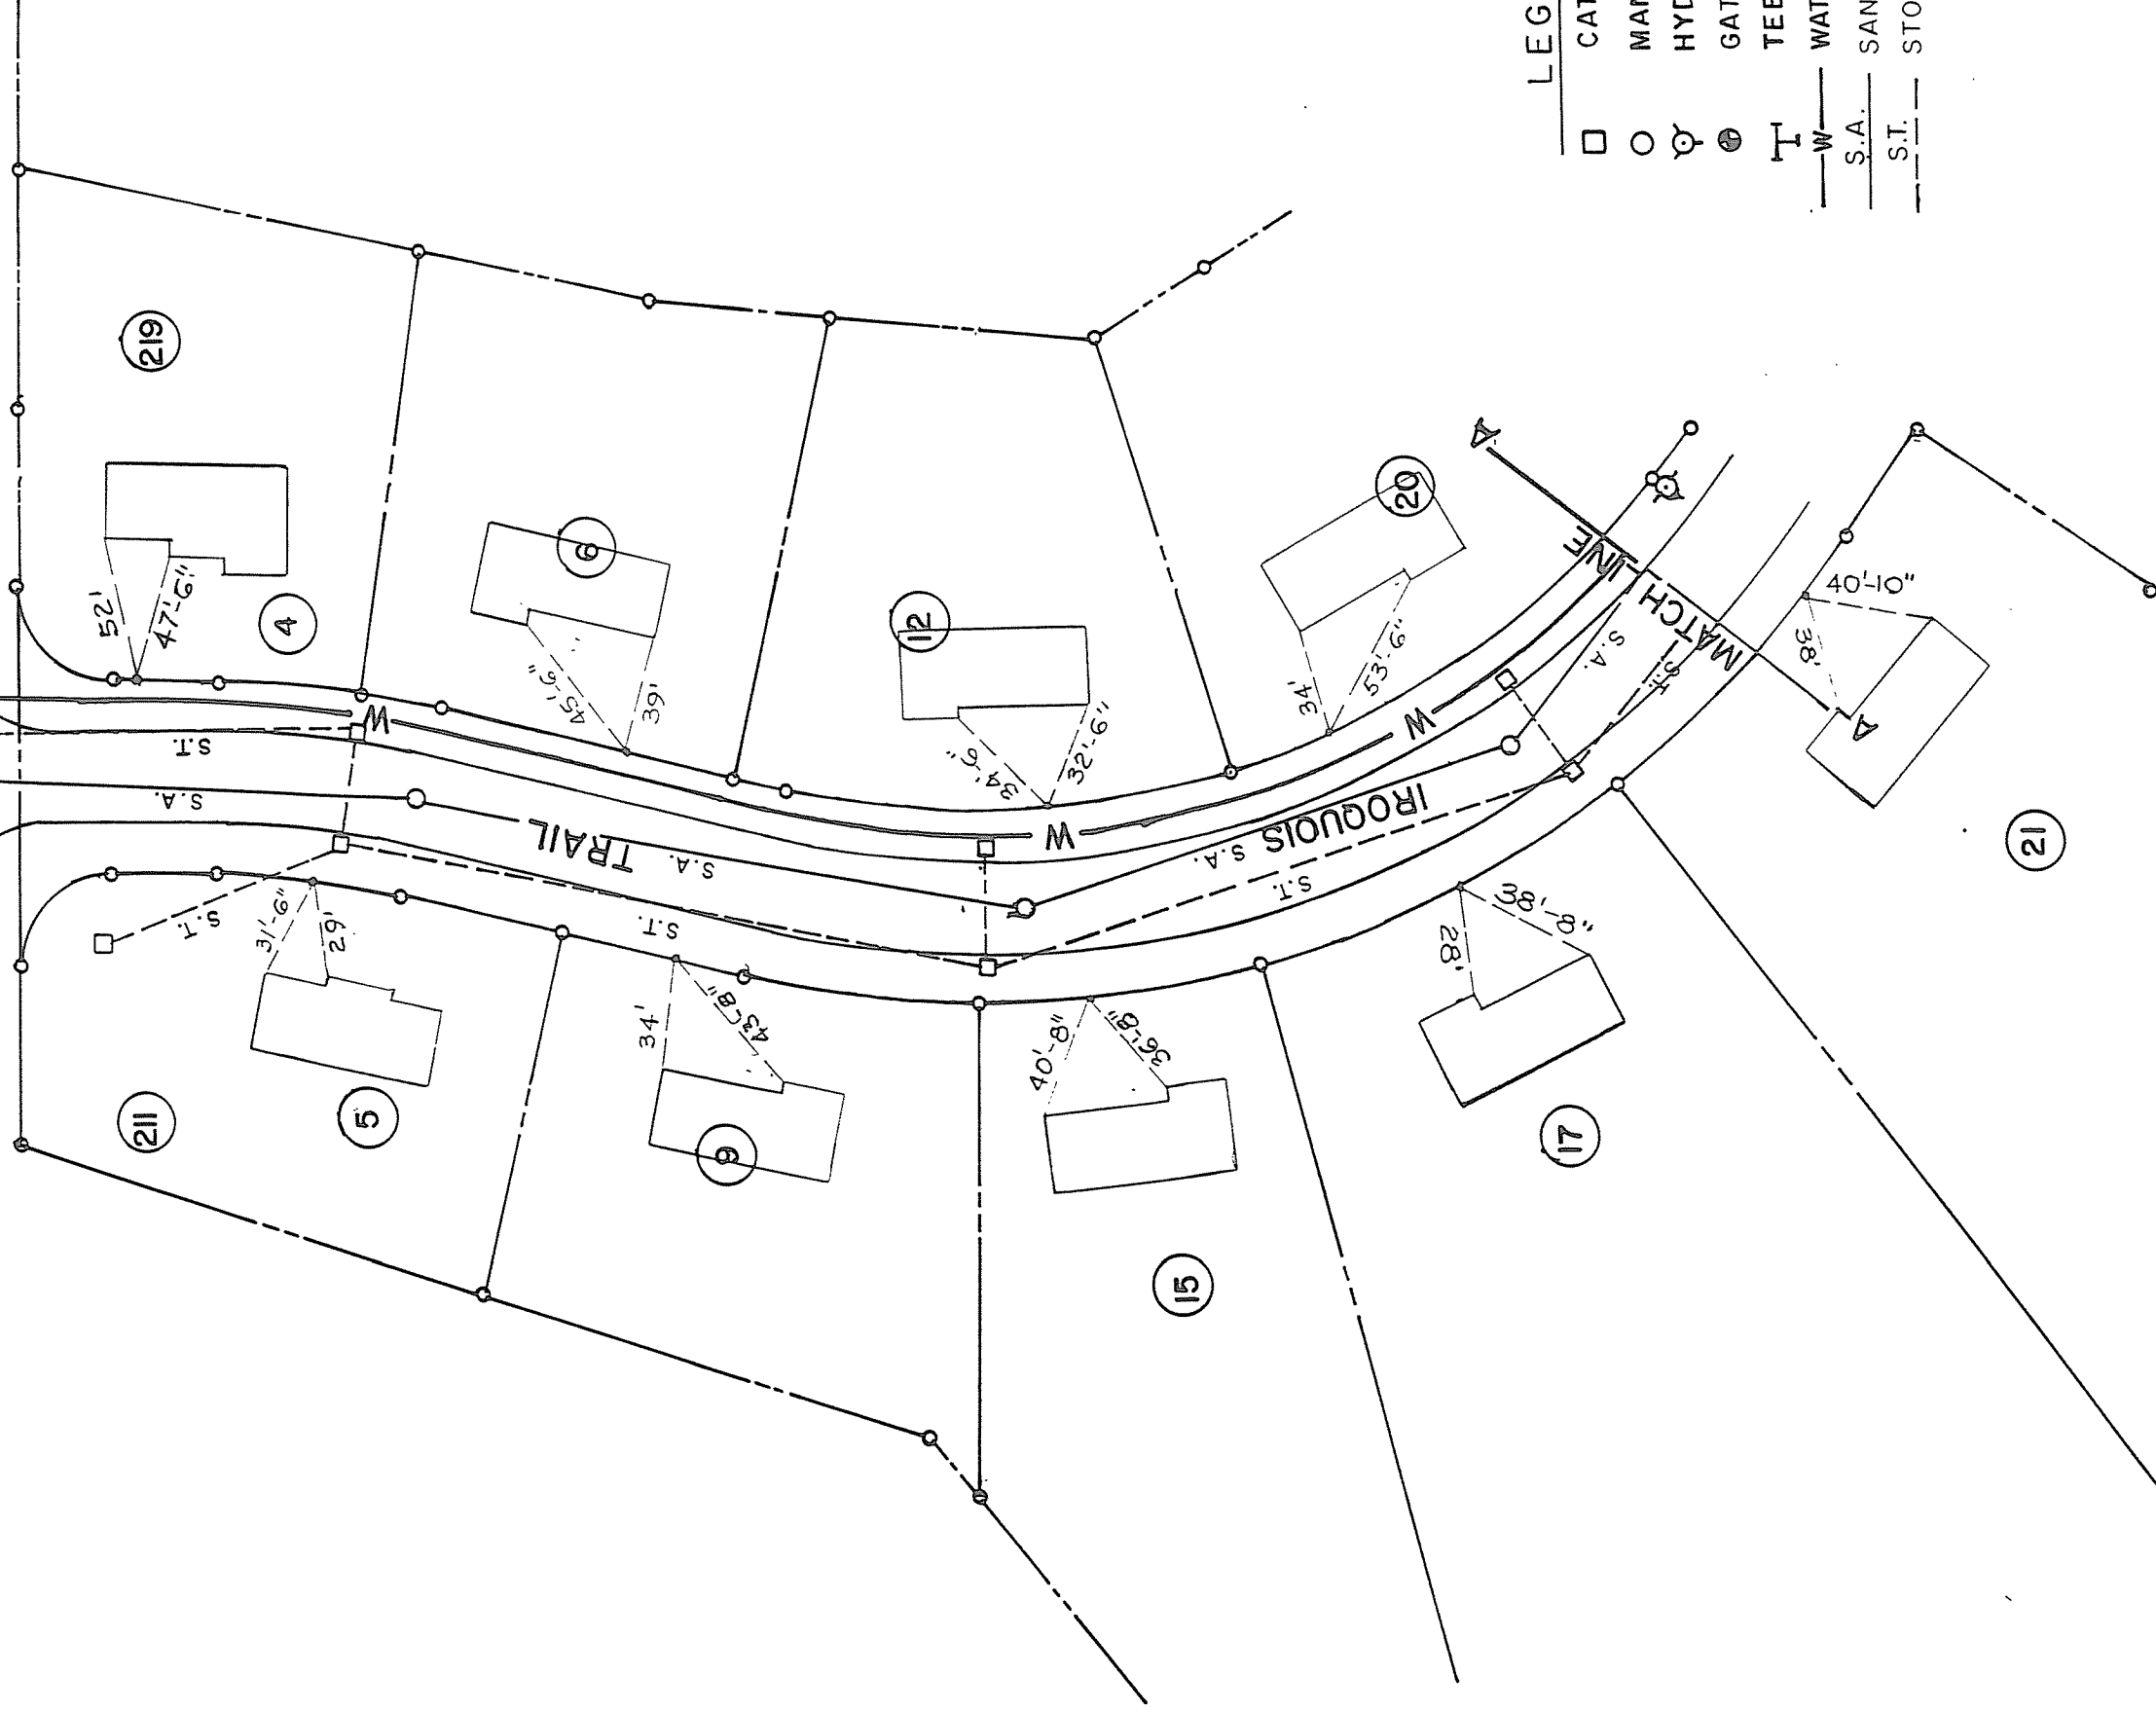

LEGEND

□	CATCH BASIN
○	MANHOLE
⊙	HYDRANT
⊗	GATE VALVE
⊥	TEE
—W—	WATER MAIN
—S.A.—	SANITARY SEWER
—S.T.—	STORM SEWER

IROQUOIS TRAIL
INDIAN HILLS
SECTION No. 3
WATER MAIN & CURB BOXES
SCALE: 1"=50' APRIL 1994

DRAWN BY: M.G.
CHECKED BY: T.W.R.