


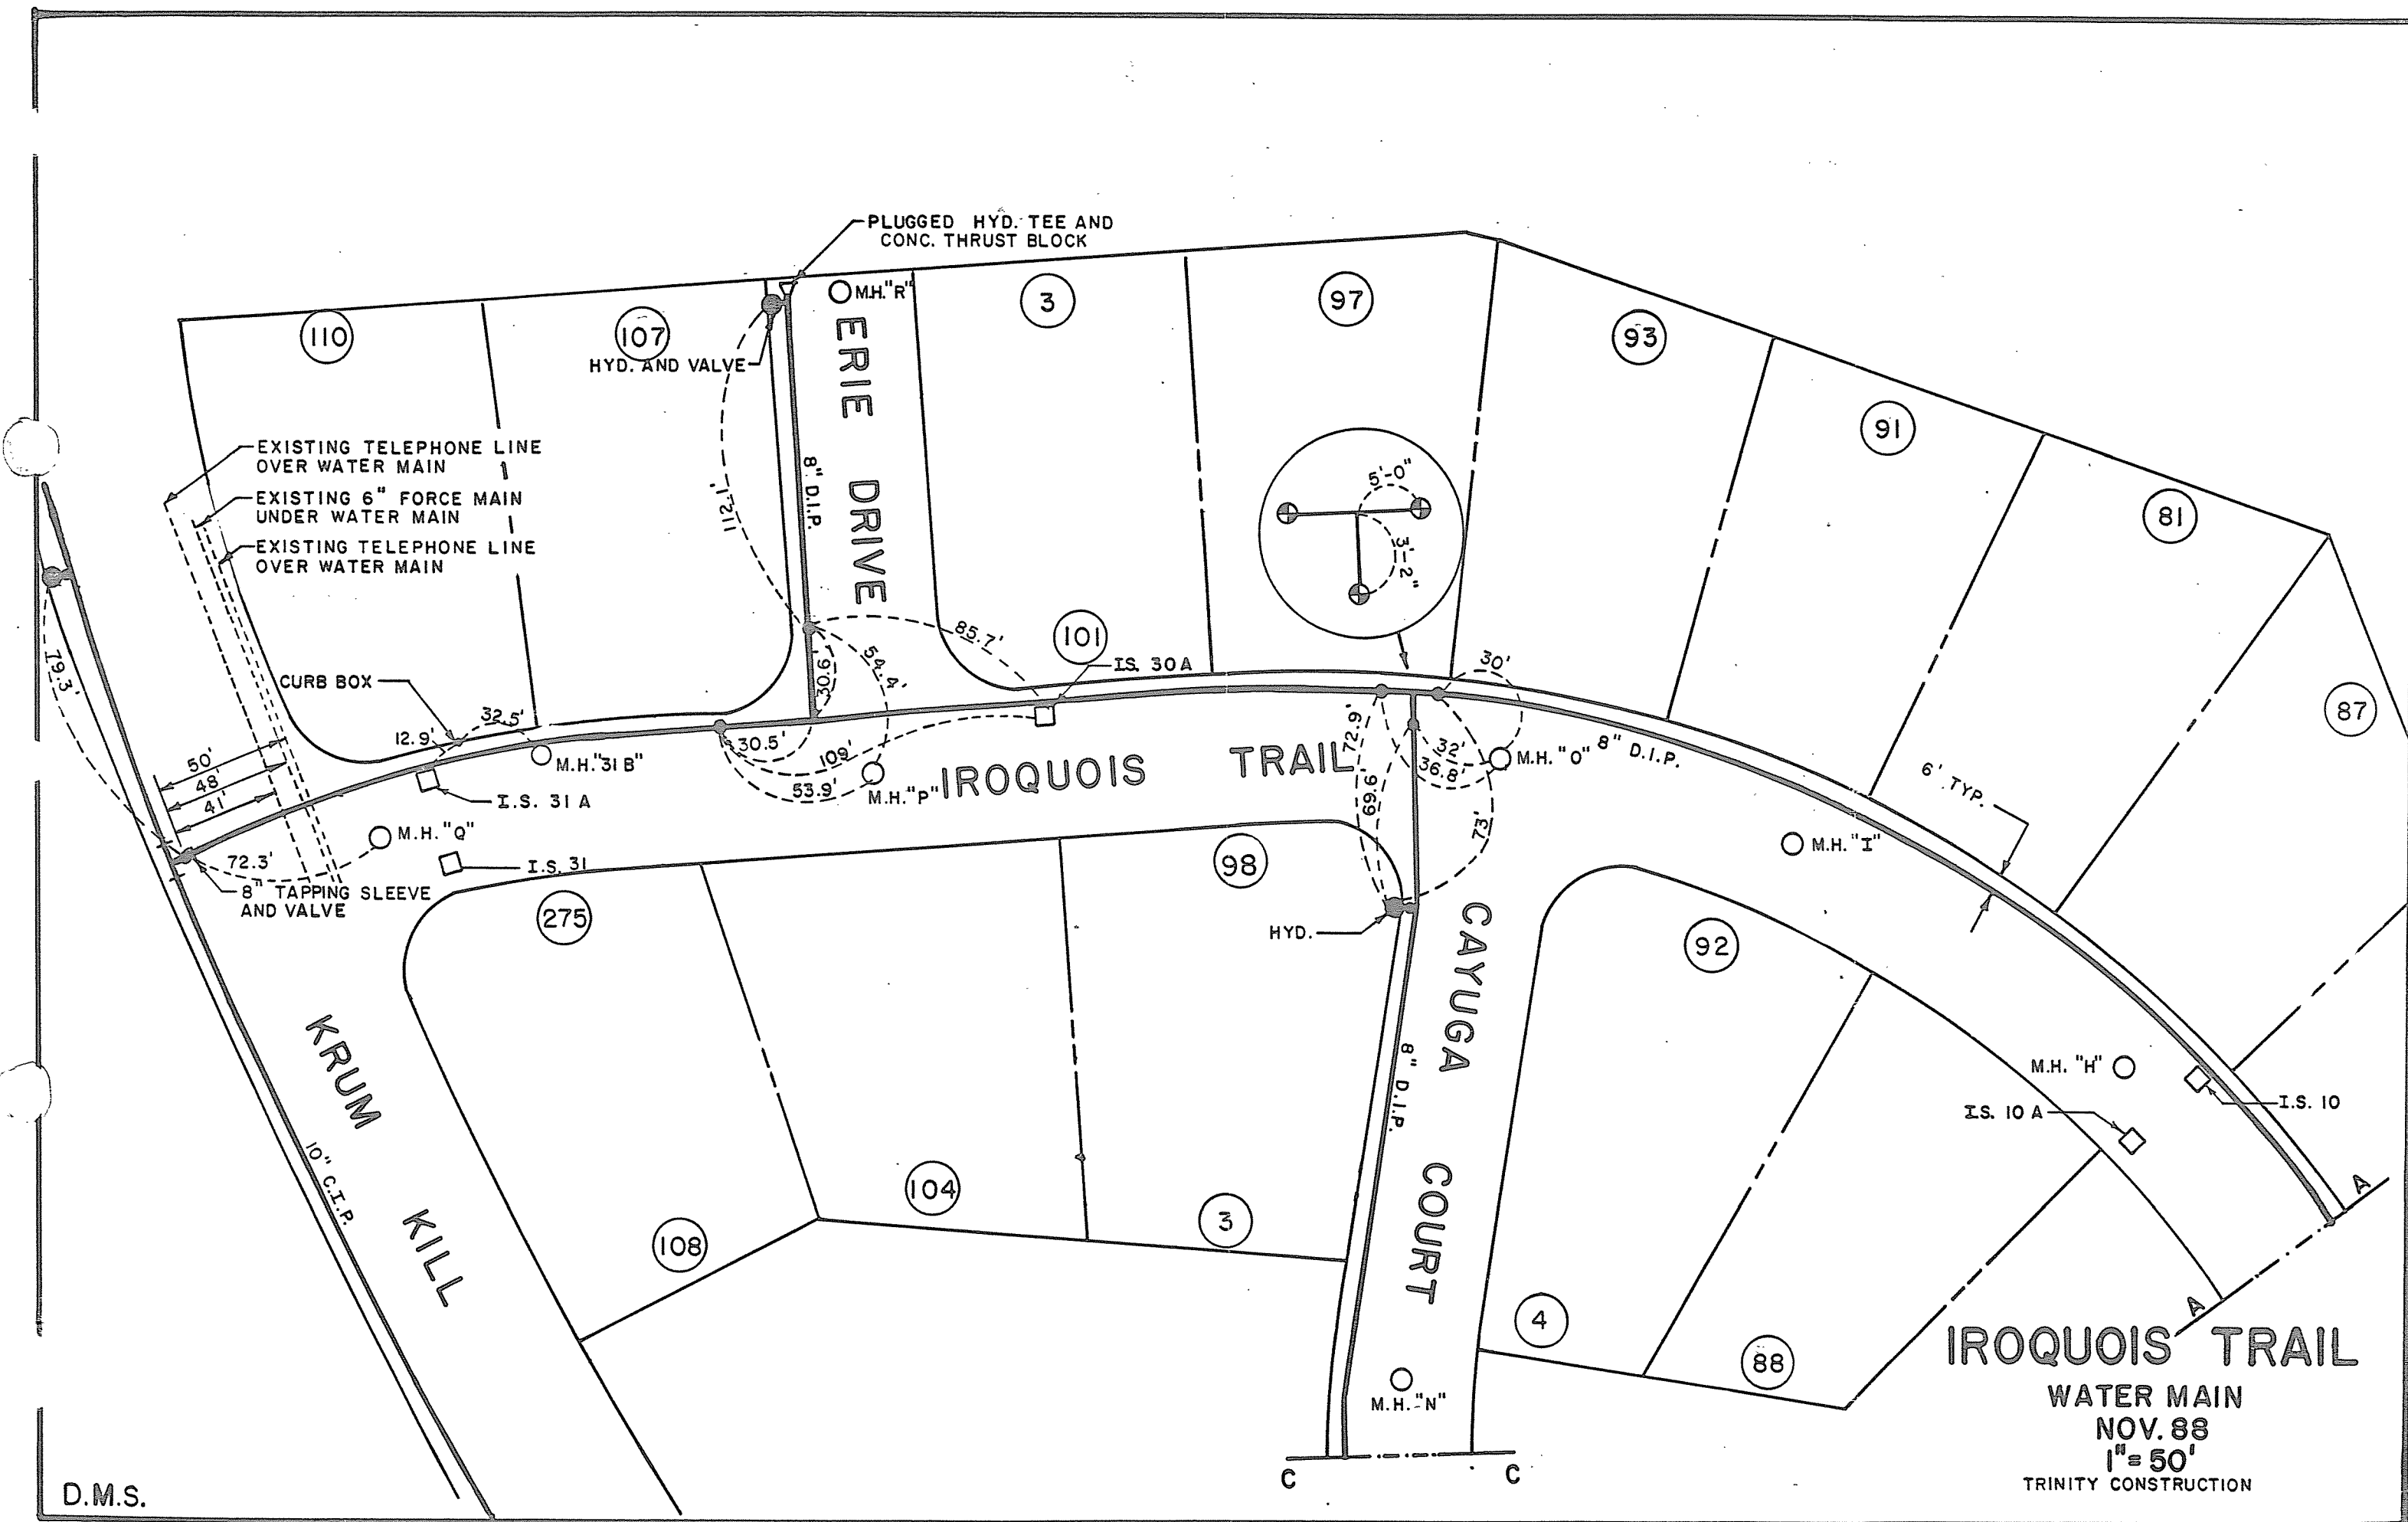

D.M.S.

IROQUOIS TRAIL
WATER MAIN
NOV. 88
1" = 50'
TRINITY CONSTRUCTION