


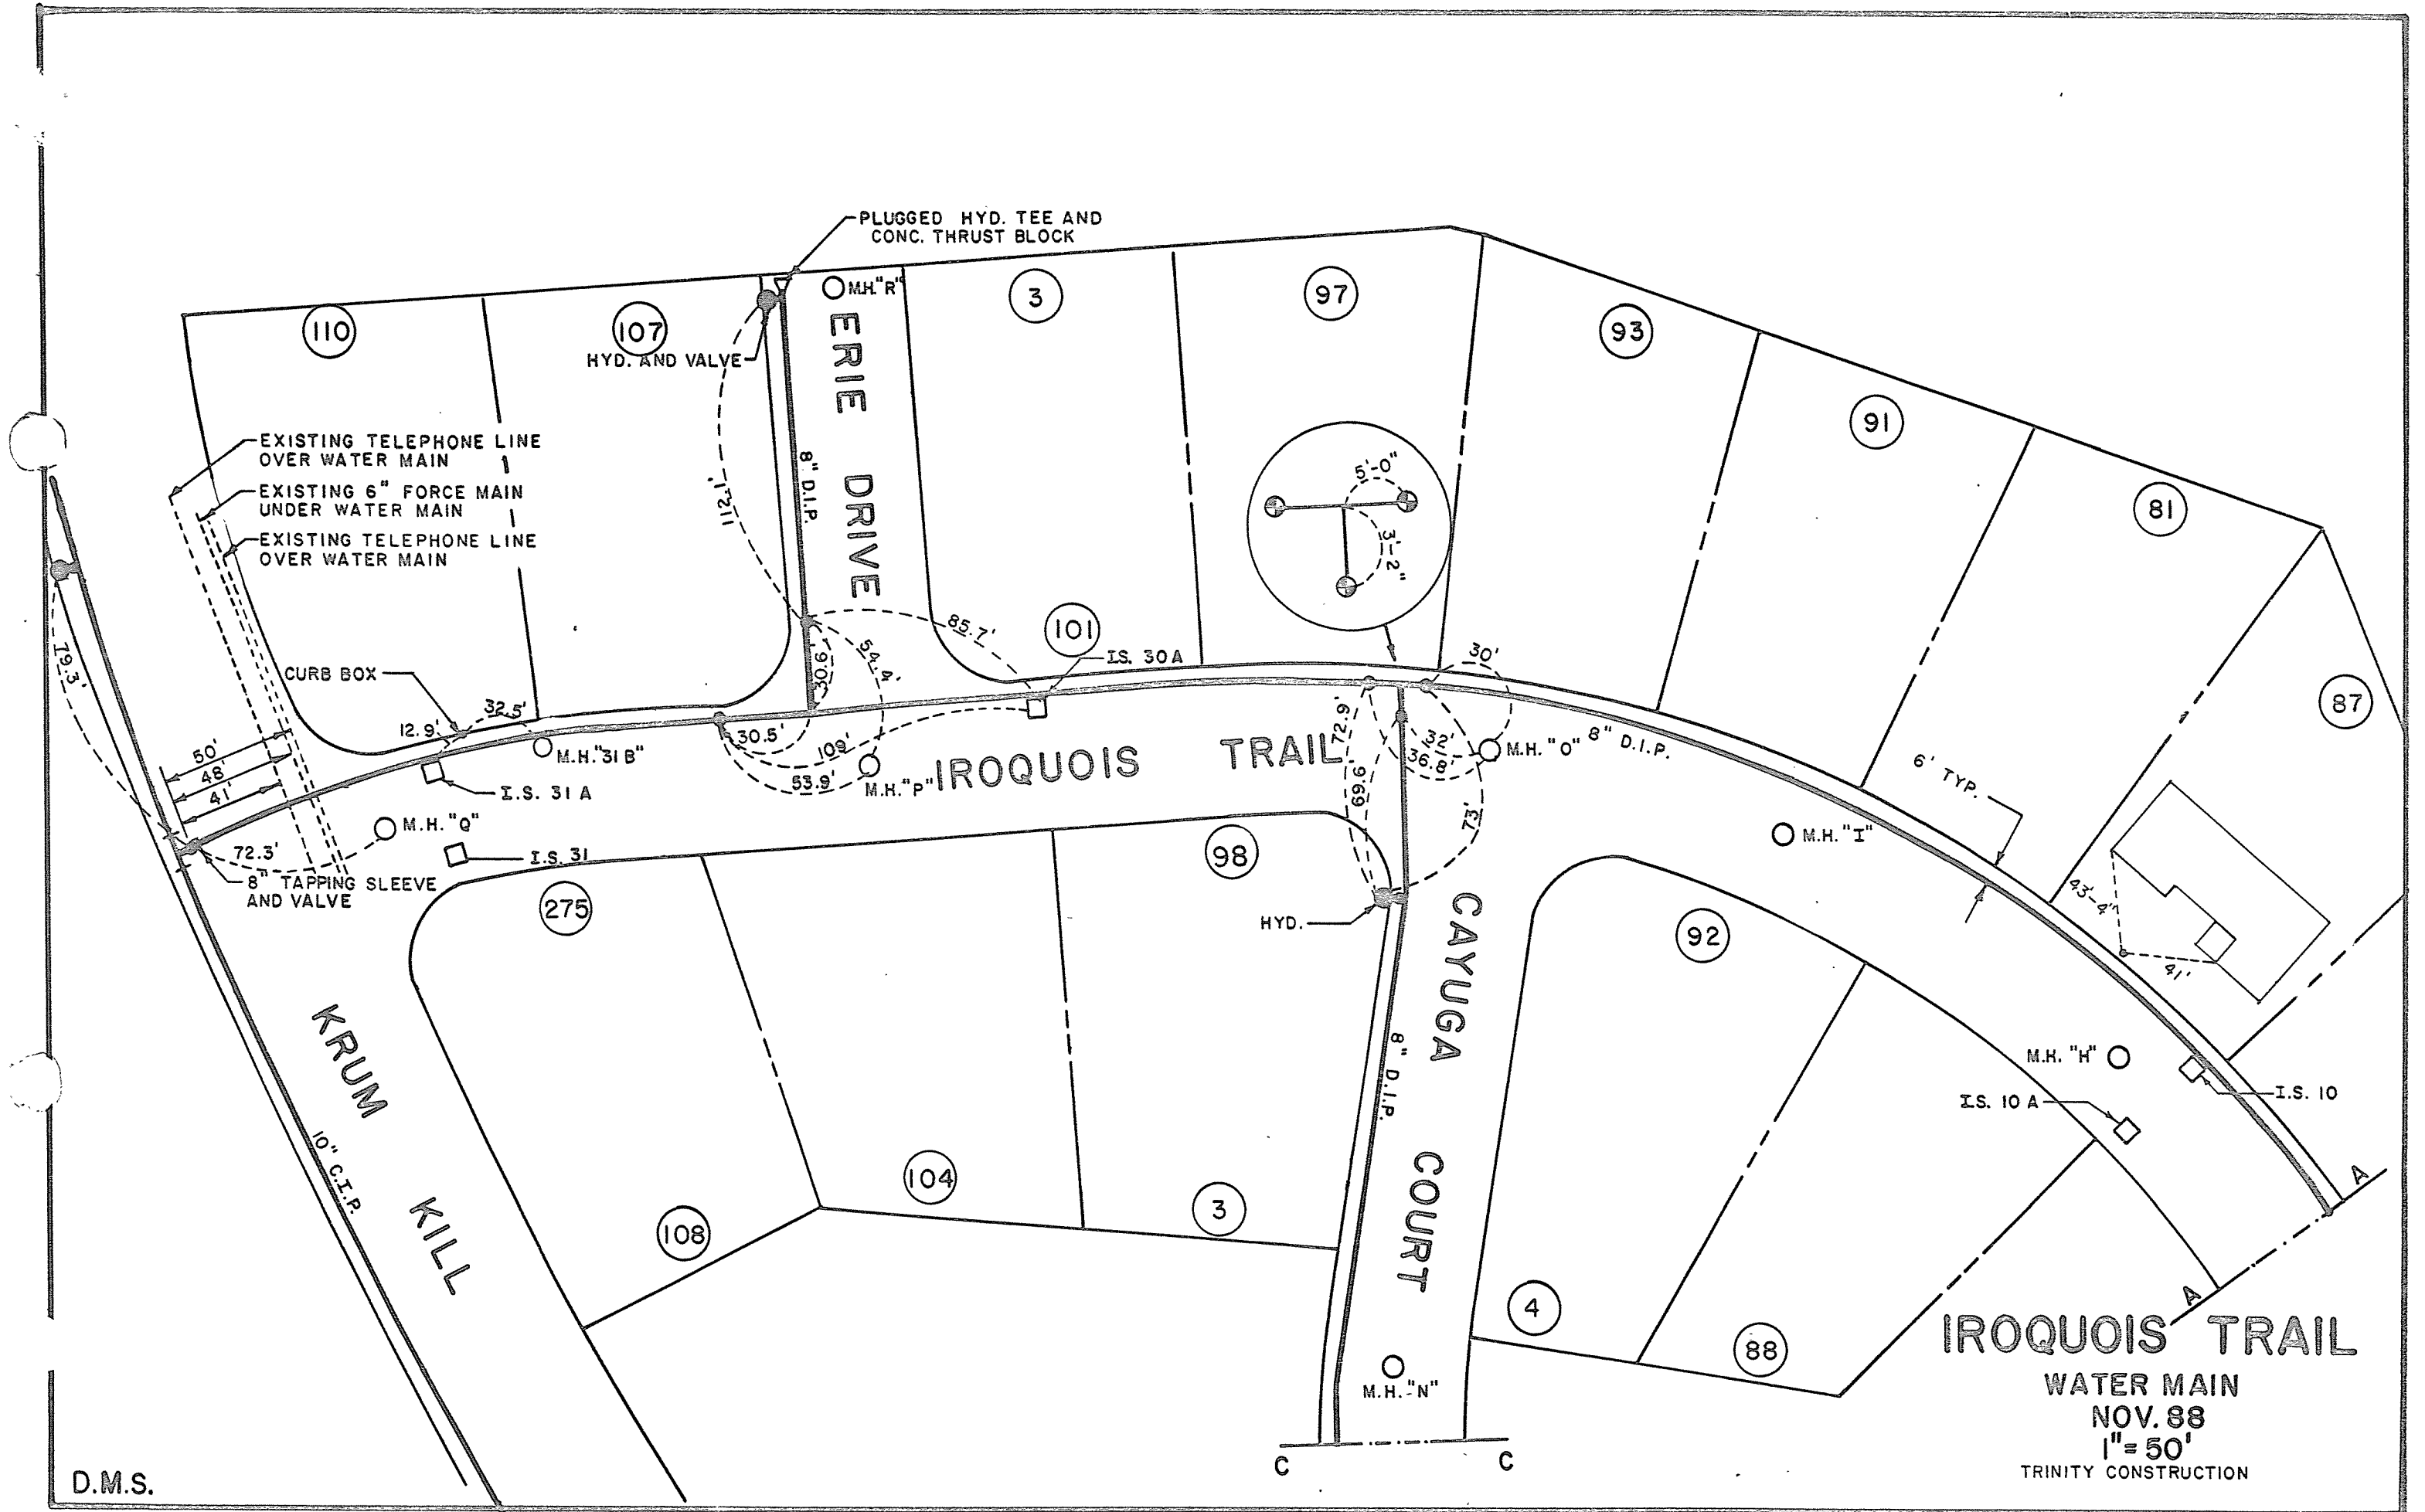

D.M.S.