


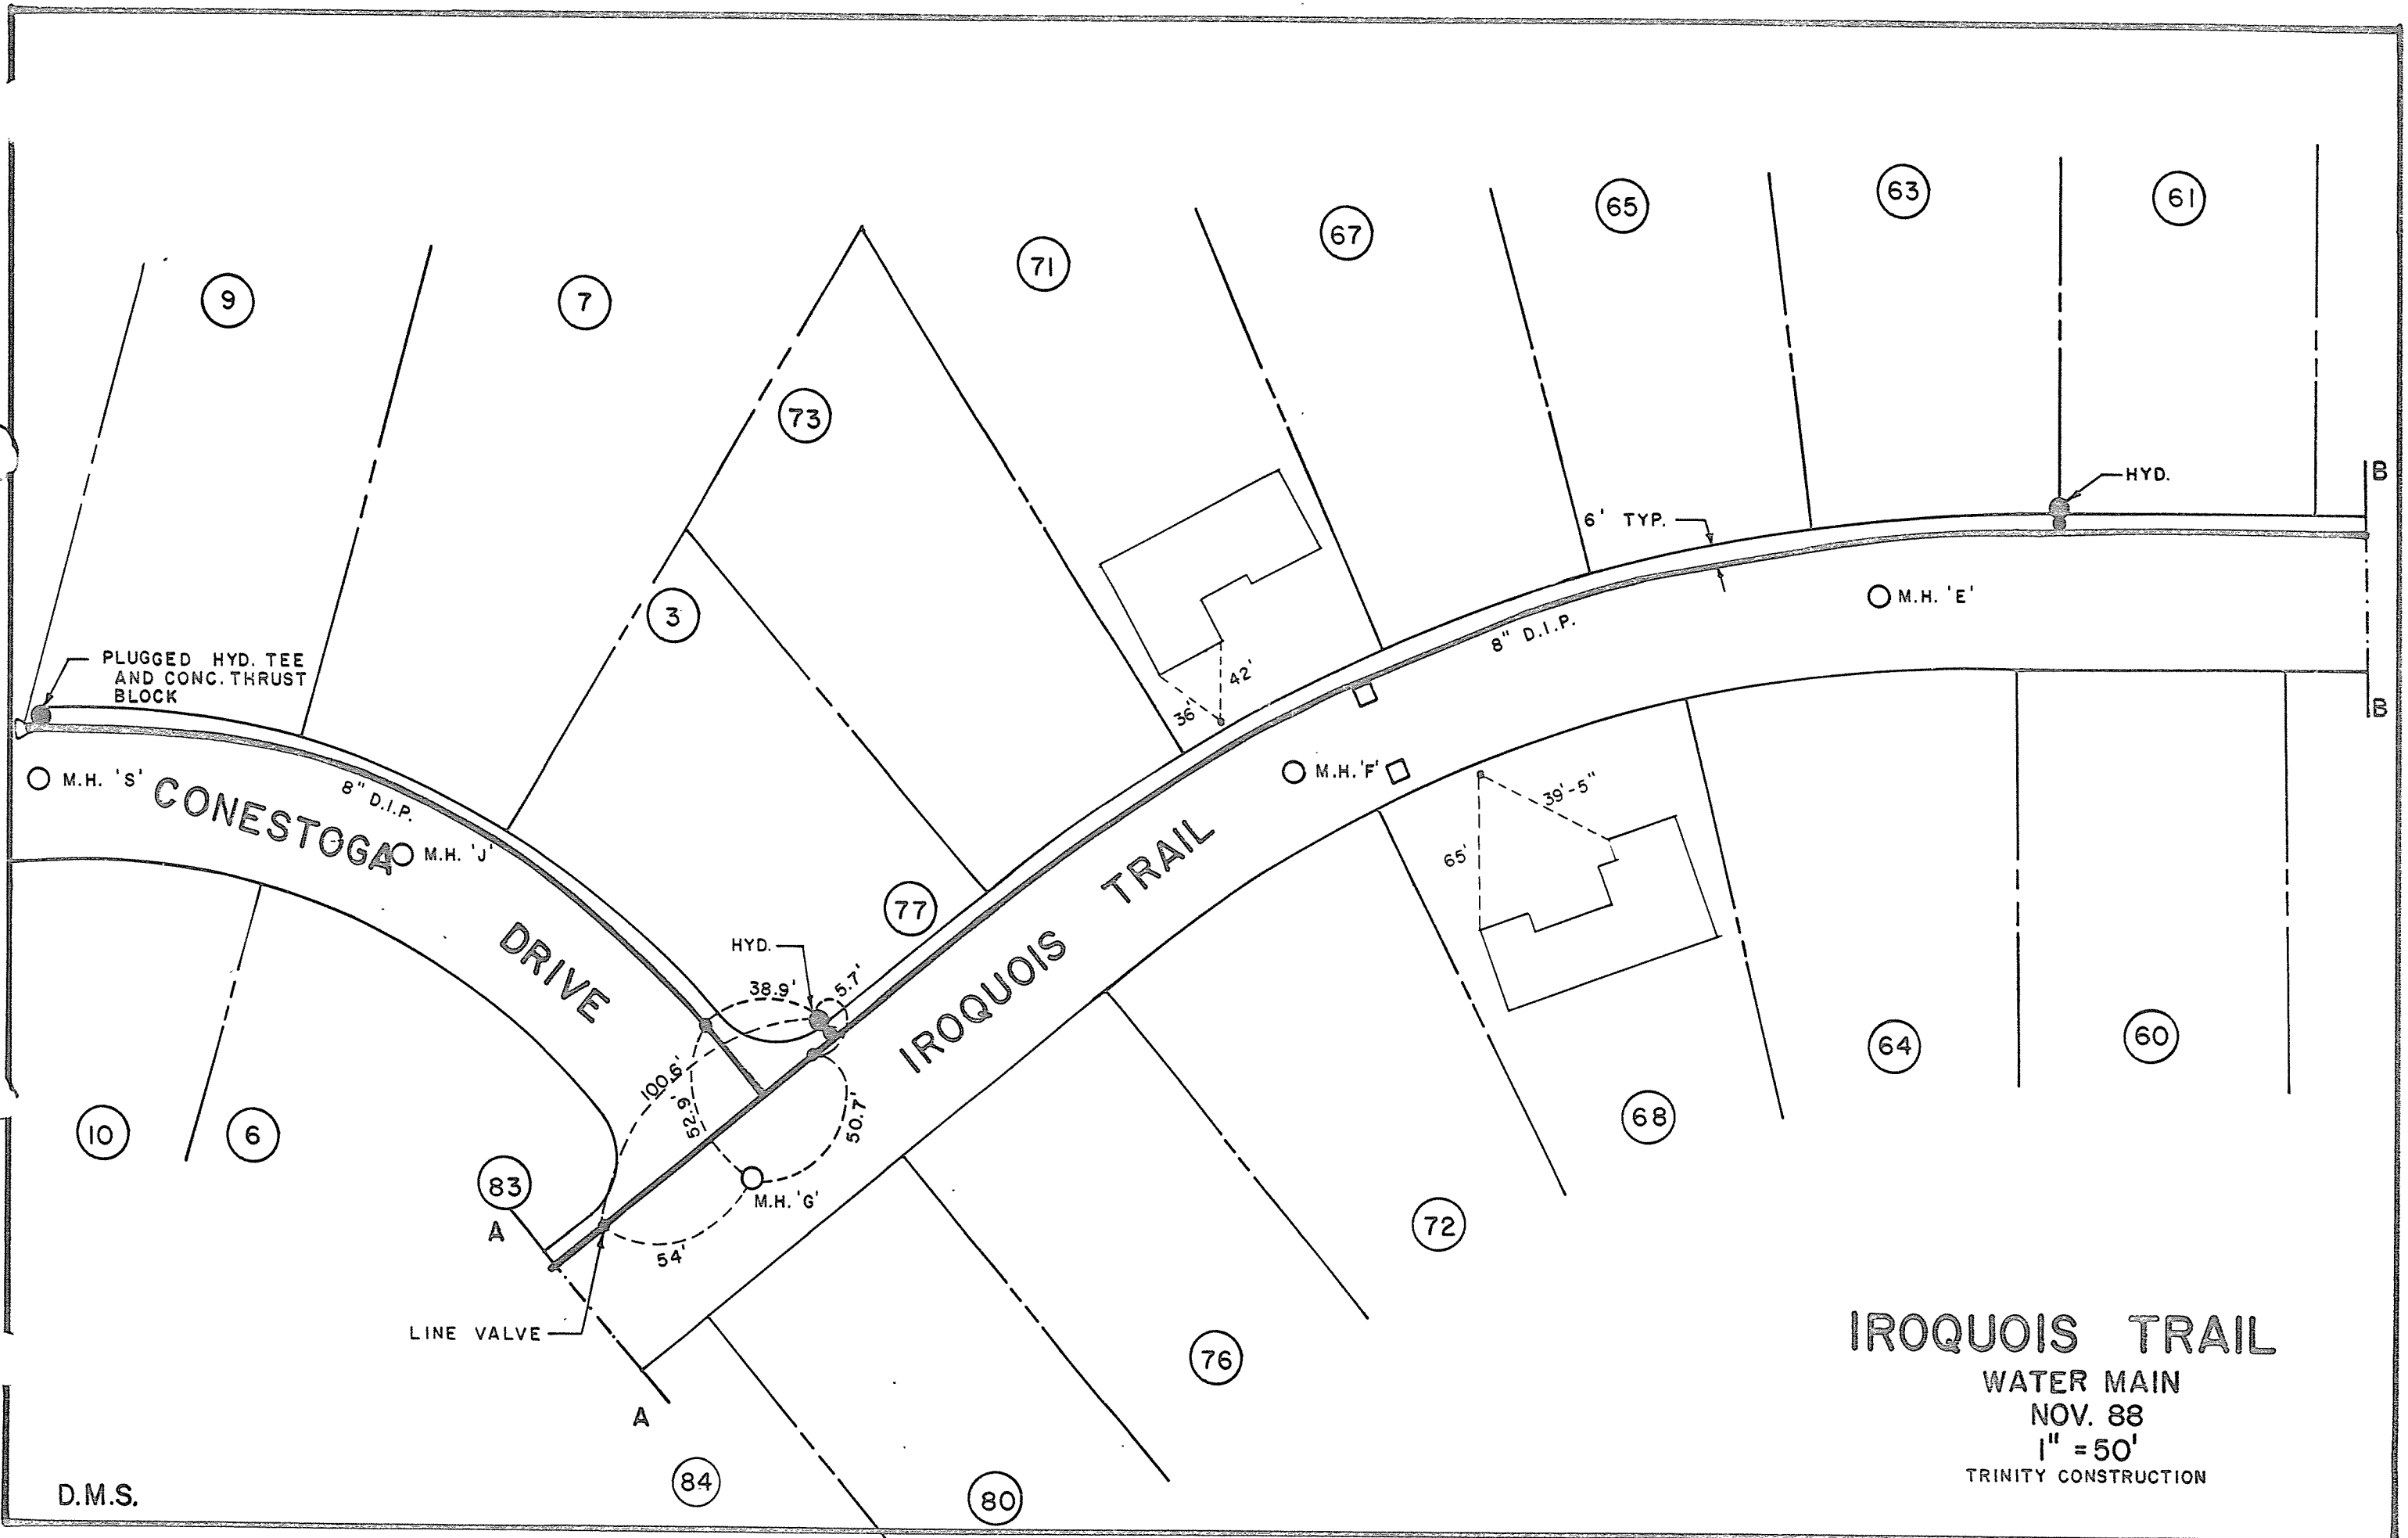

IROQUOIS TRAIL

WATER MAIN

NOV. 88

1" = 50'

TRINITY CONSTRUCTION

D.M.S.